


# T.4S.R.2W.W.M.

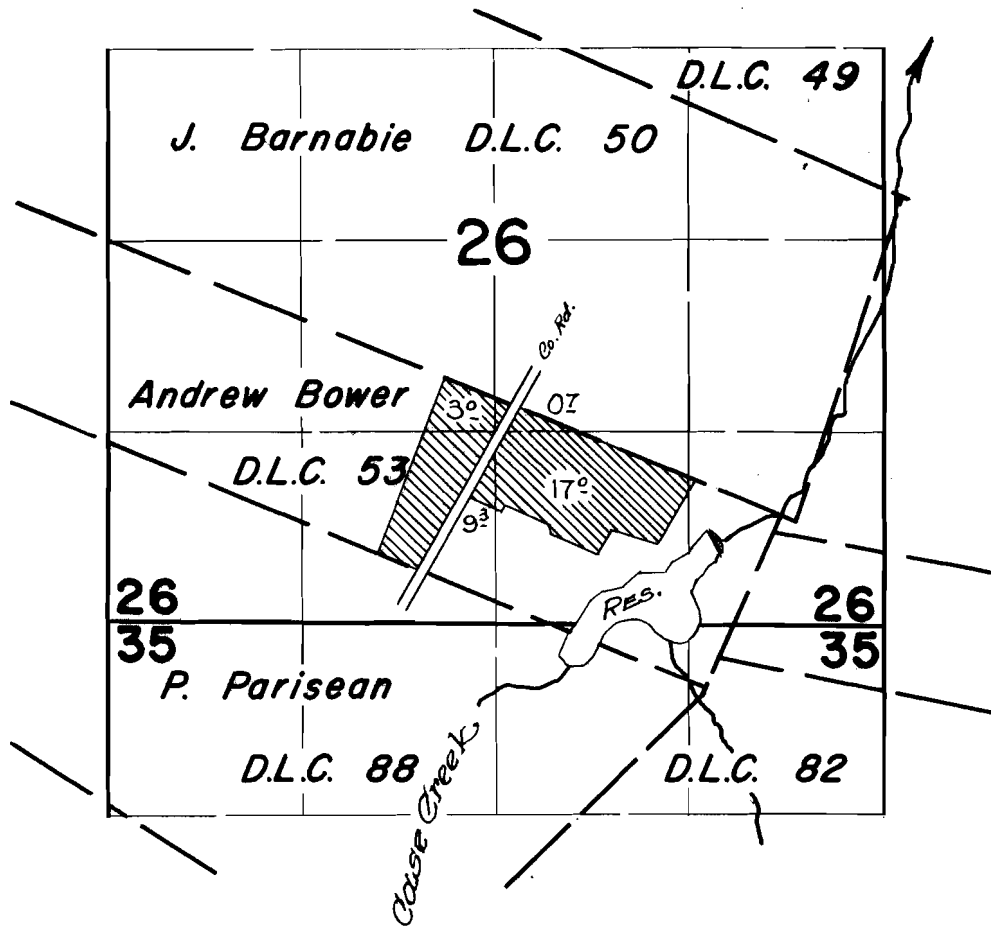

## FINAL PROOF SURVEY UNDER

R-37821                      R-3086  
Application No. 37822    Permit No. 28202  
IN NAME OF

NEAL W. MILLER

Surveyed July 3, 1963, by T. Lauer