


T.4S.R.2W.W.M.

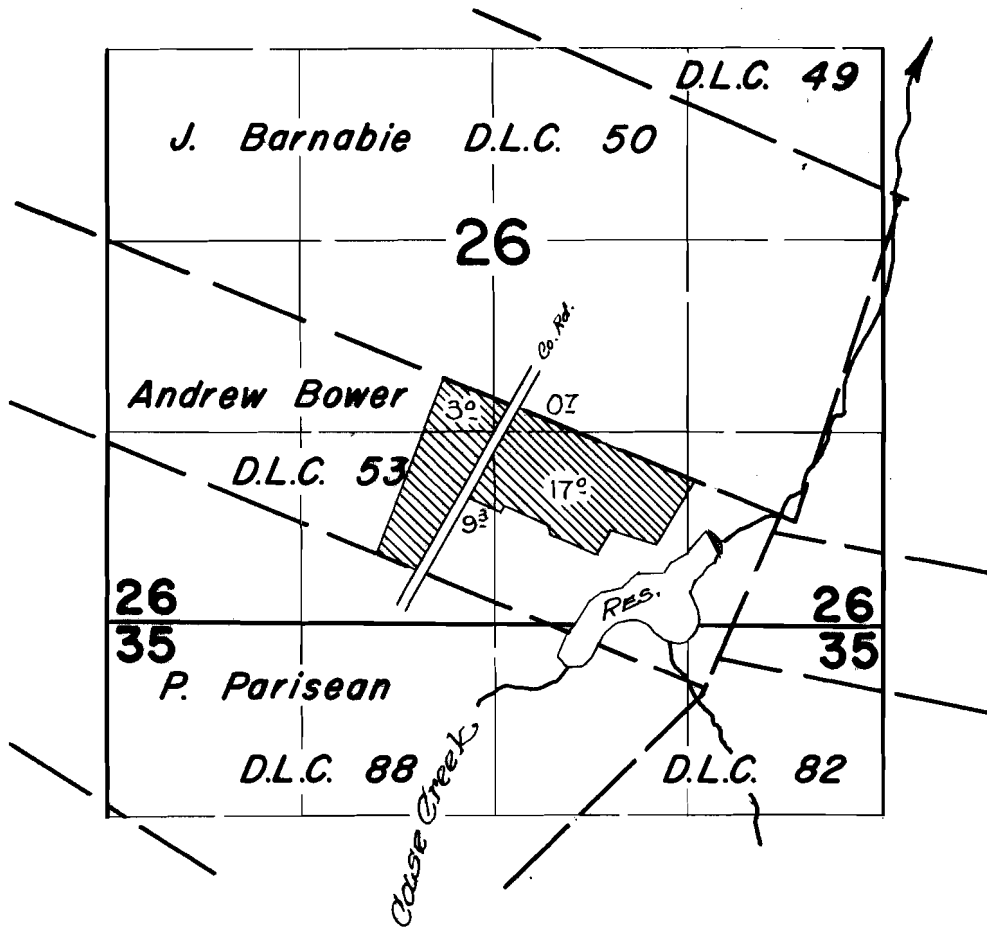

FINAL PROOF SURVEY UNDER

R-37821 R-3086
Application No. 37822 Permit No. 28202
IN NAME OF

.....NEAL W. MILLER.....

Surveyed July 3, 1963, by T. Lauer.....