


T. 15. R. 4 E. W. M.

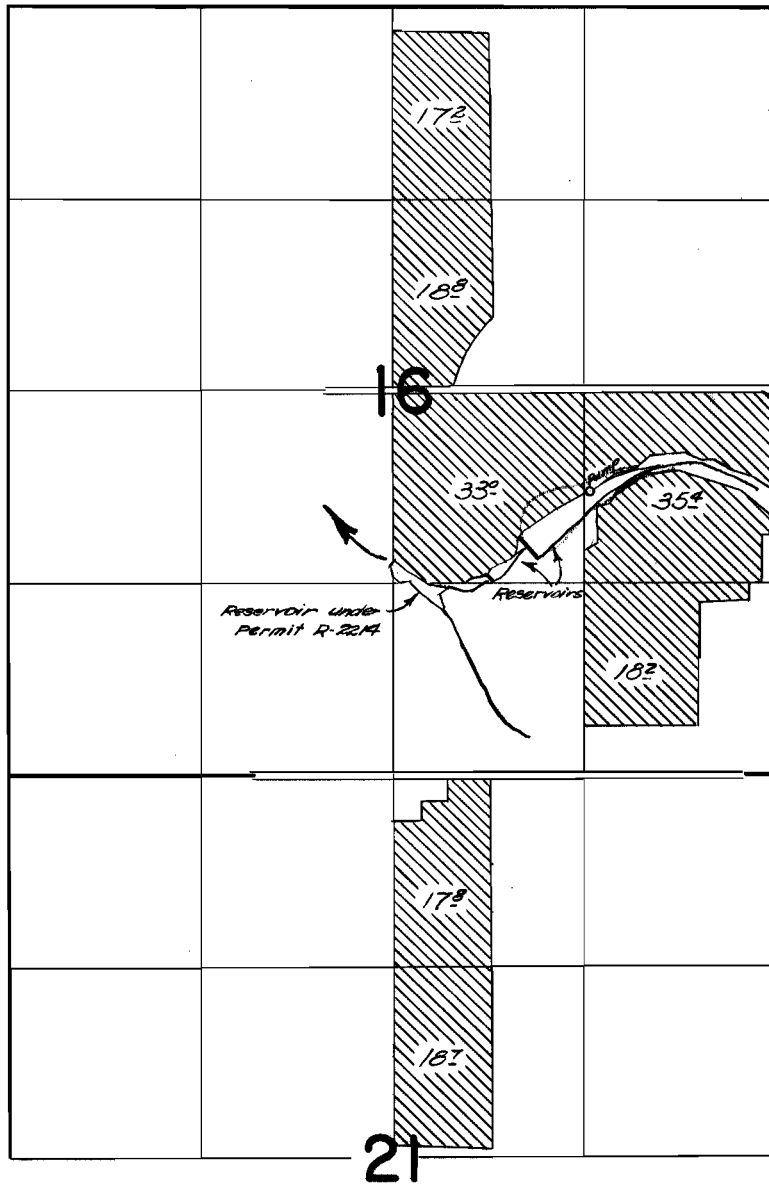

FINAL PROOF SURVEY UNDER

R-32587 R-2214
Application No. 32875. Permit No. 25965...
IN NAME OF

..... WILLIAM H. SESTER

Surveyed July 25 1963, by T. Lauer.....