


# T. 15. R. 4 E. W. M.

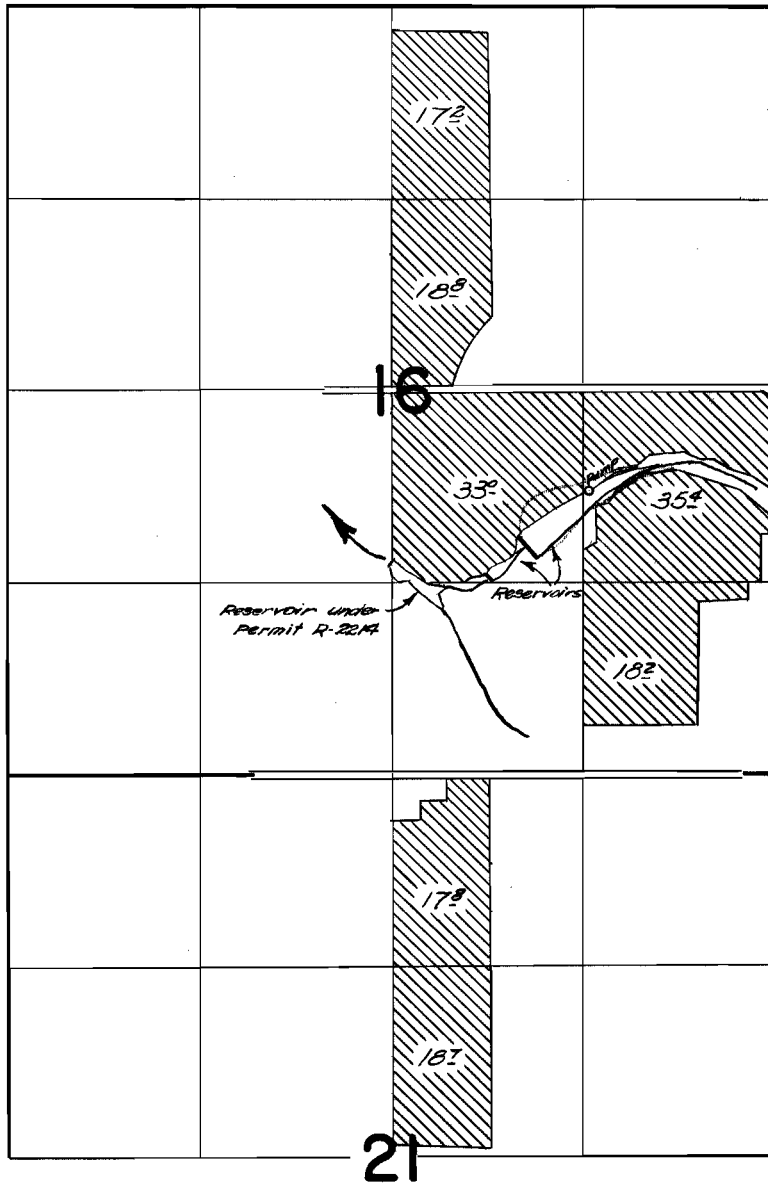

## FINAL PROOF SURVEY UNDER

R-32587                      R-2214  
Application No. 32875. Permit No. 25965...  
IN NAME OF

..... WILLIAM H. SESTER .....

Surveyed July 25 1963, by T. Lauer.....