


T. 7S. R. 3W. W.M.

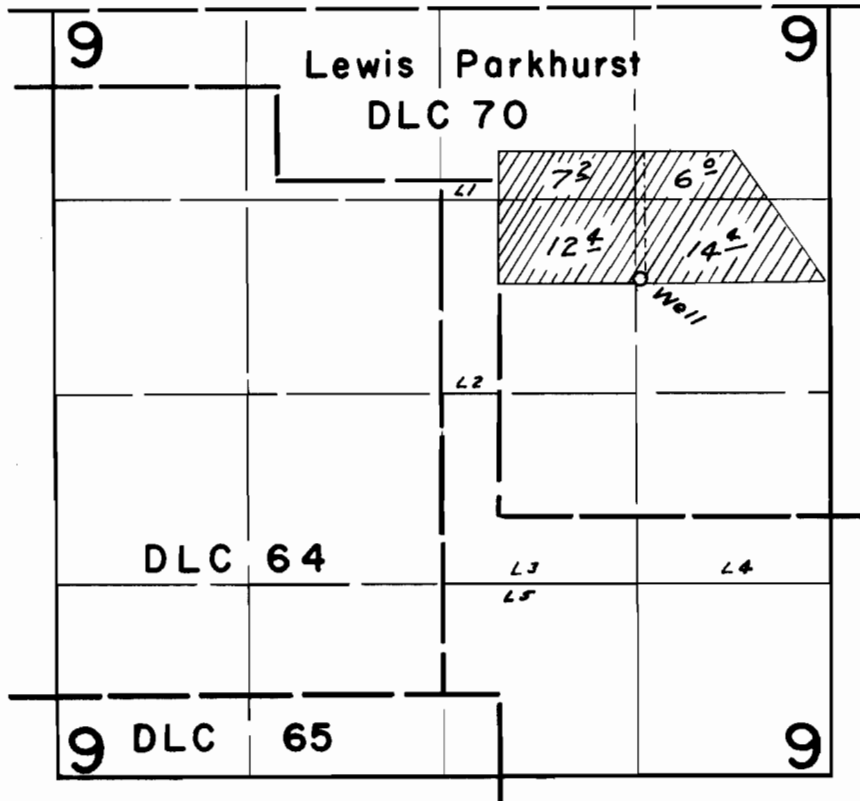

**FINAL PROOF SURVEY**  
UNDER

Application No. G-2535 Permit No. G-2325  
IN NAME OF

DONALD BLAKE

Surveyed Sept. 22, 1964, by C. J. Gardner