


T. 10S. R. 6W. W.M.

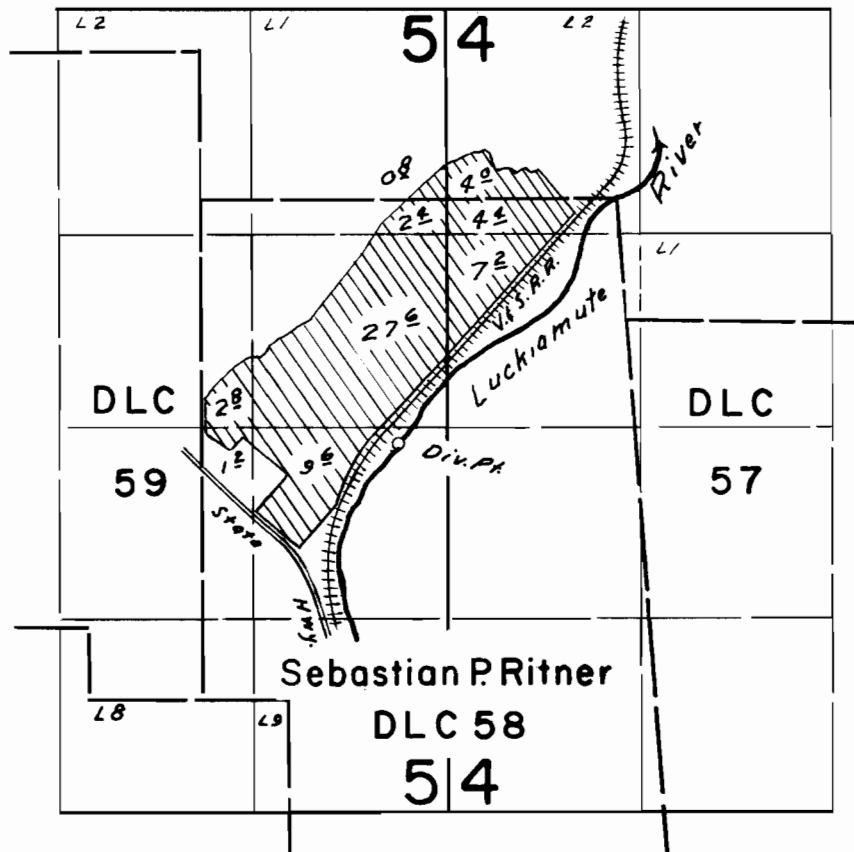

FINAL PROOF SURVEY UNDER

Application No. 34090 Permit No. 26858
IN NAME OF

H. J. HUKARI

Surveyed Sept. 23, 1964 by *C. J. Gardner*