


T.8S.R.4W. W.M.

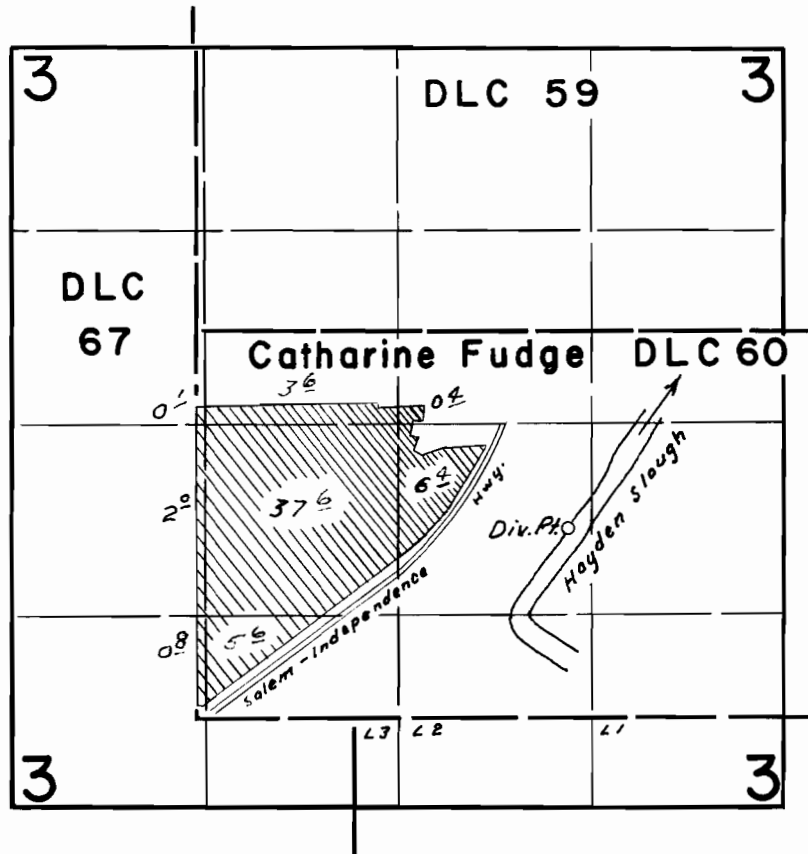

FINAL PROOF SURVEY
UNDER

Application No. 34869 Permit No. 27367...

IN NAME OF

CHESTER & KATHRYN BACIGALUPI

Surveyed Sept. 22, 1964, by C.J. Gardner.....