


T.9S.R.4W. W.M.

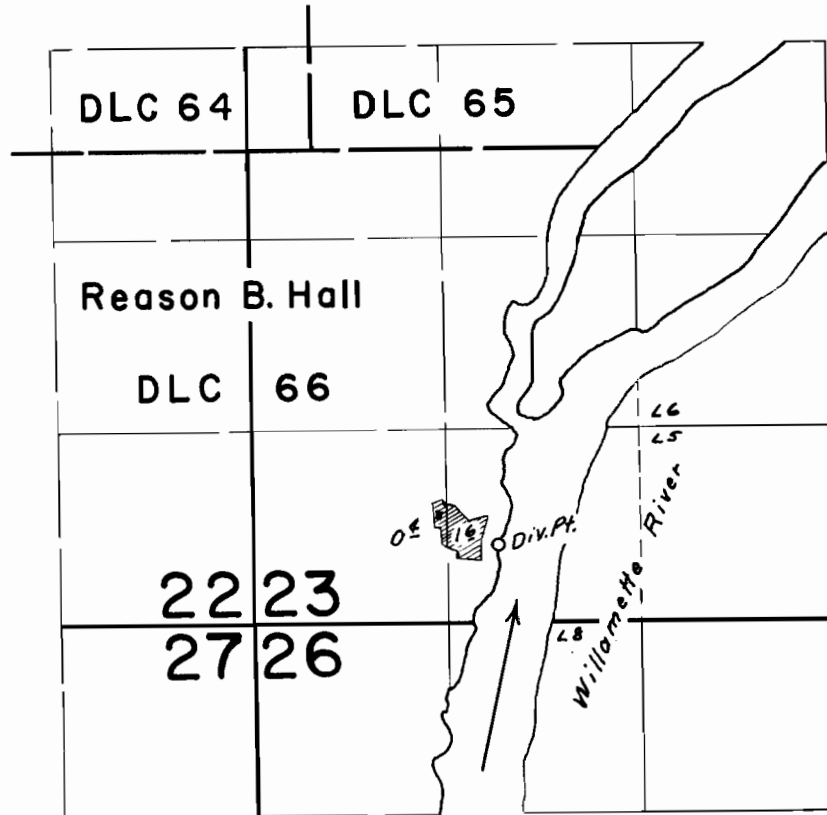

FINAL PROOF SURVEY
UNDER

Application No. 35066 Permit No. 27451
IN NAME OF

ELMER WIERINGA

Surveyed Sept. 24, 1964, by *C.J. Gardner*