





# T.9S.R.5W.W.M.

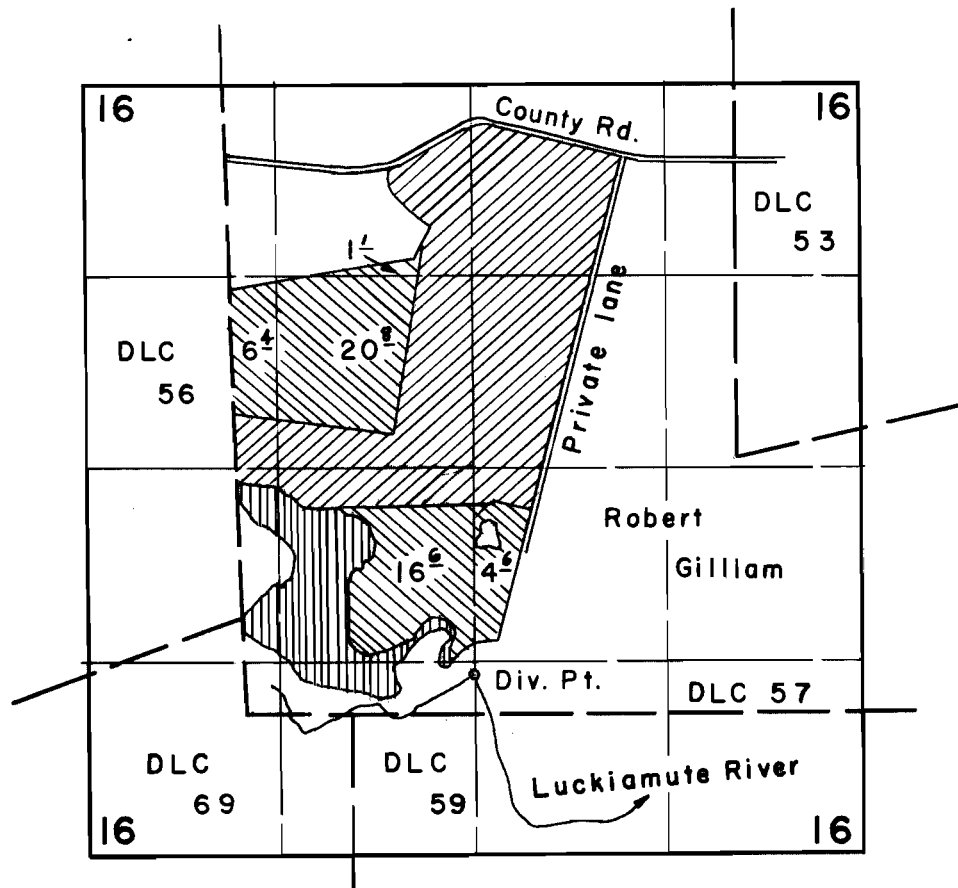

-  Permit No. 22749
-  Permit No. 28464
-  Irrigated but no permit

## FINAL PROOF SURVEY UNDER

Application No. 38196... Permit No. 28464...  
IN NAME OF

..... Ivan H. Loughary .....

Surveyed Sept. 23 1964, by C.J.Gardner.....