


T.7S.R.6W. W.M.

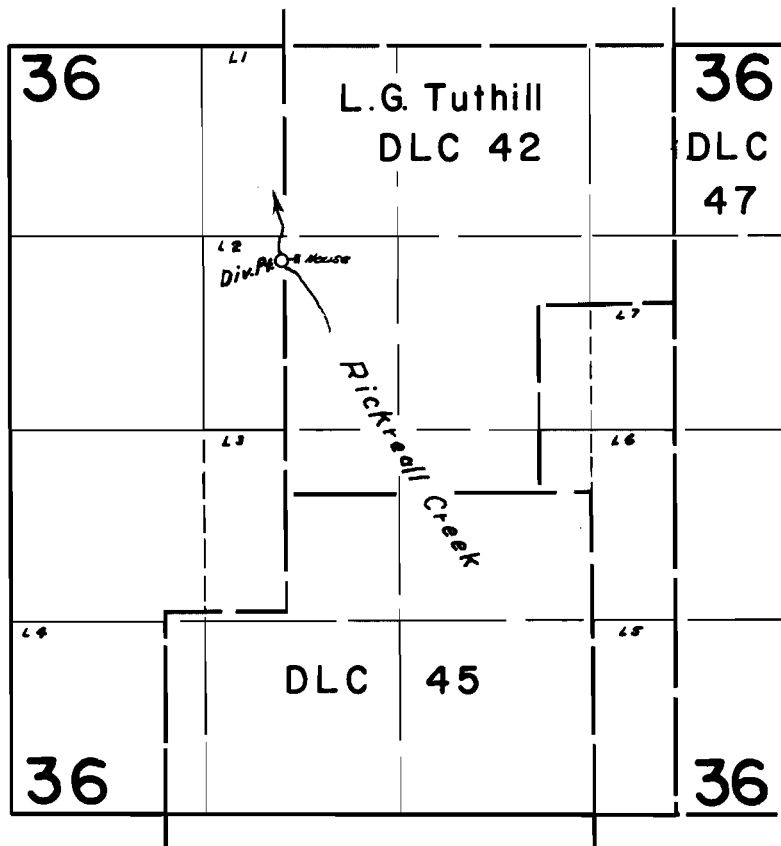

**FINAL PROOF SURVEY**  
UNDER

Application No. 39186 Permit No. 29141  
IN NAME OF

RALPH P. & BERTHA M. HOWE

Surveyed Sept. 24, 1964, by C.V. Gardner