


# T. 7 S. R. 6 W. W. M.

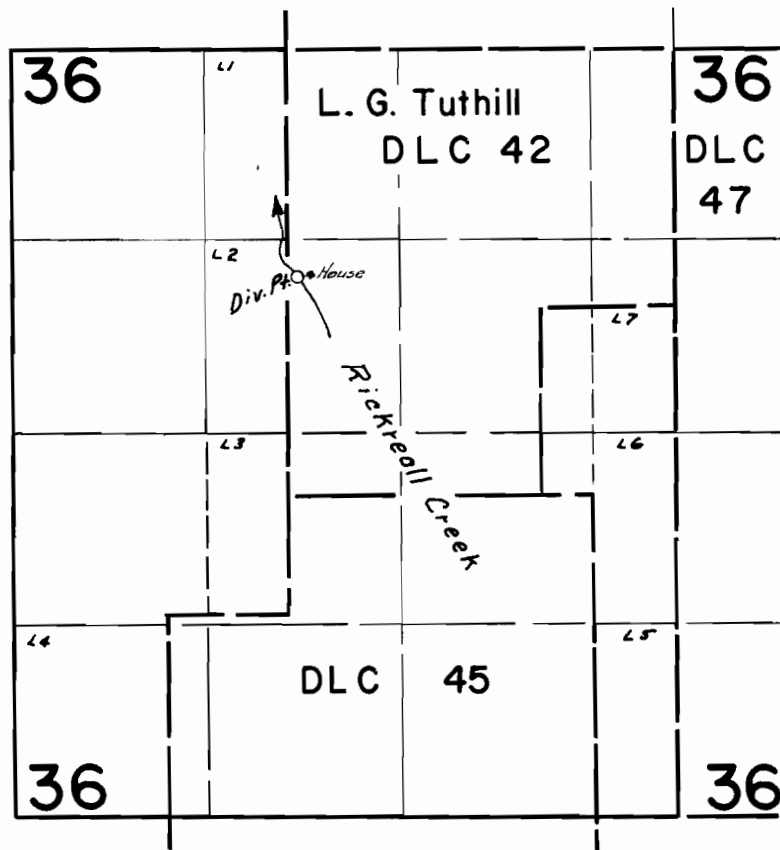

## FINAL PROOF SURVEY UNDER

Application No. 39460... Permit No. 29388...  
IN NAME OF

**ALBERT & ALTHEA BURELBACH**

Surveyed Sept. 24, 1964., by *C. J. Gardner*...



















































































