


# T.3N.R27E.W.M.

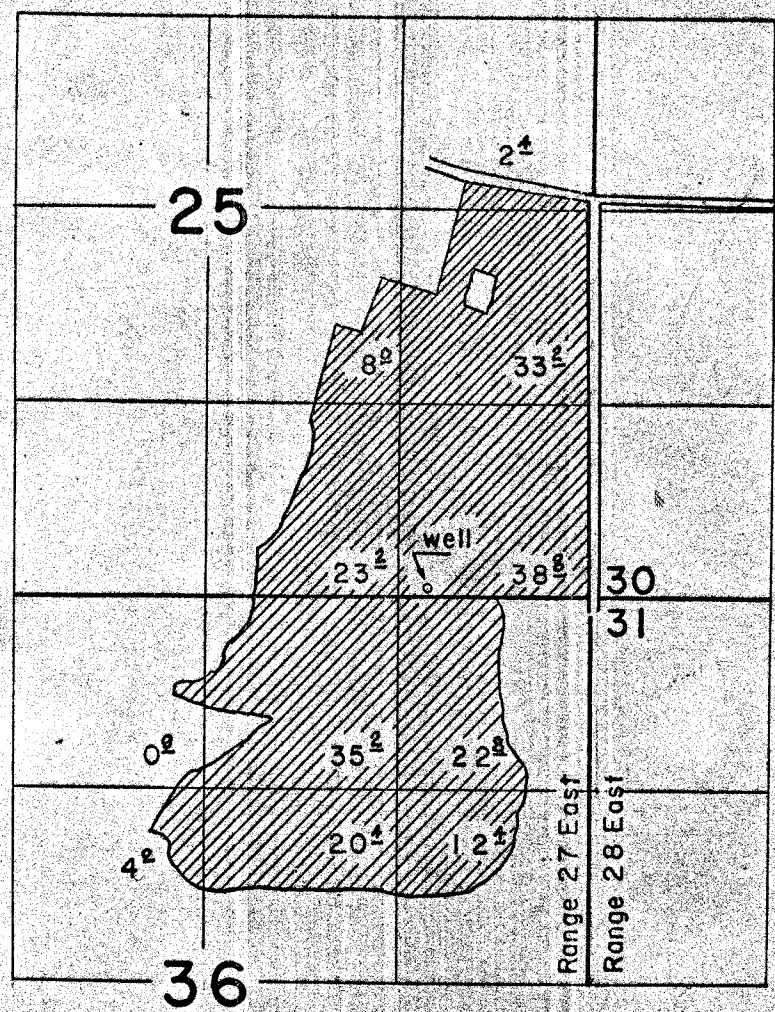

## FINAL PROOF SURVEY UNDER

Application No. G-1845. Permit No. G-1688...  
IN NAME OF

.....George B. Wallace.....

Surveyed Aug. 22, 1964, by C.J. Gardner...