


# T.6N.R.33E.W.M.

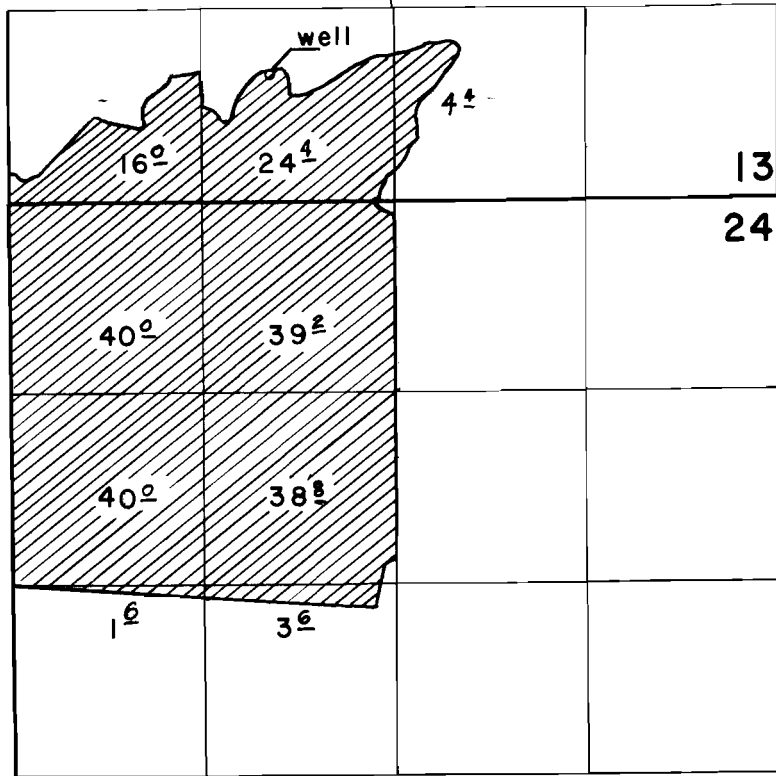

## FINAL PROOF SURVEY UNDER

Application No. G-2051 Permit No. G-1897  
IN NAME OF

John L. Geyer

Surveyed Aug. 24, 1964, by C.J. Gardner