

G-2262

8.8 ac.
Proof #645
Certificate No. 13121
Walla Walla River Decree

SW 1/4 NE 1/4
8.2 ac.


SE 1/4 NE 1/4
G-2262

Future Sump
Location

Private
Road

PUMP

WALLA WALLA RIVER
Old pt. of Dr.

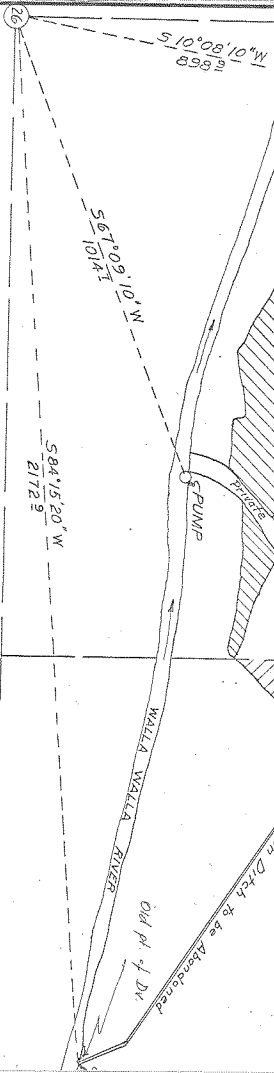

J. WAYNE O. HARRIS, COUNTY SURVEYOR

HAYES

Apply
Permit