


# T.6N.R.34E.W.M.

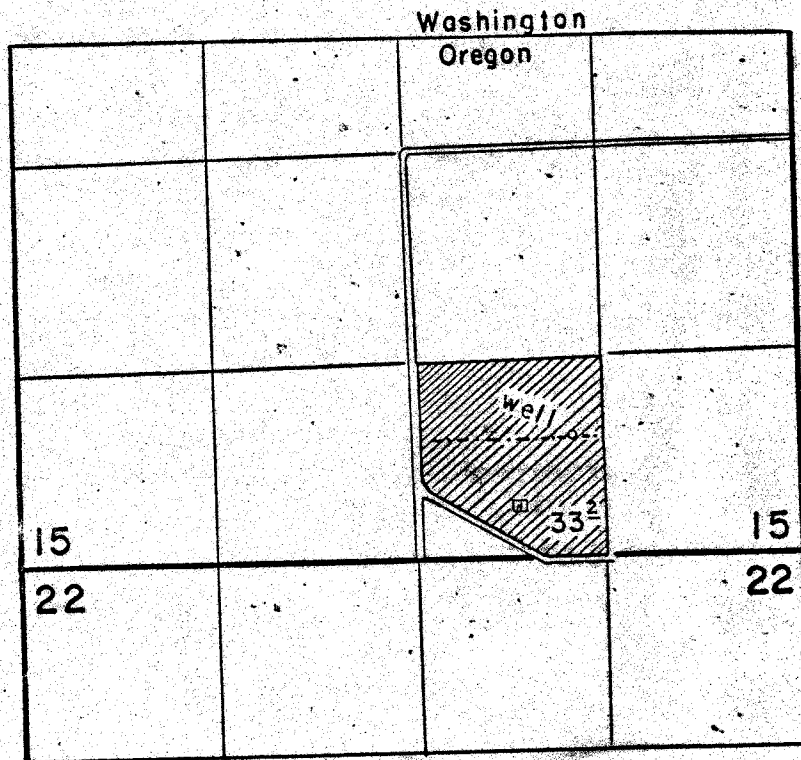

## FINAL PROOF SURVEY UNDER

Application No. G-2603 Permit No. G-2420  
IN NAME OF

Ervin Kessler

Surveyed Aug. 25 1964, by G.J. Gardner