


T.3N.R.28E.W.M.

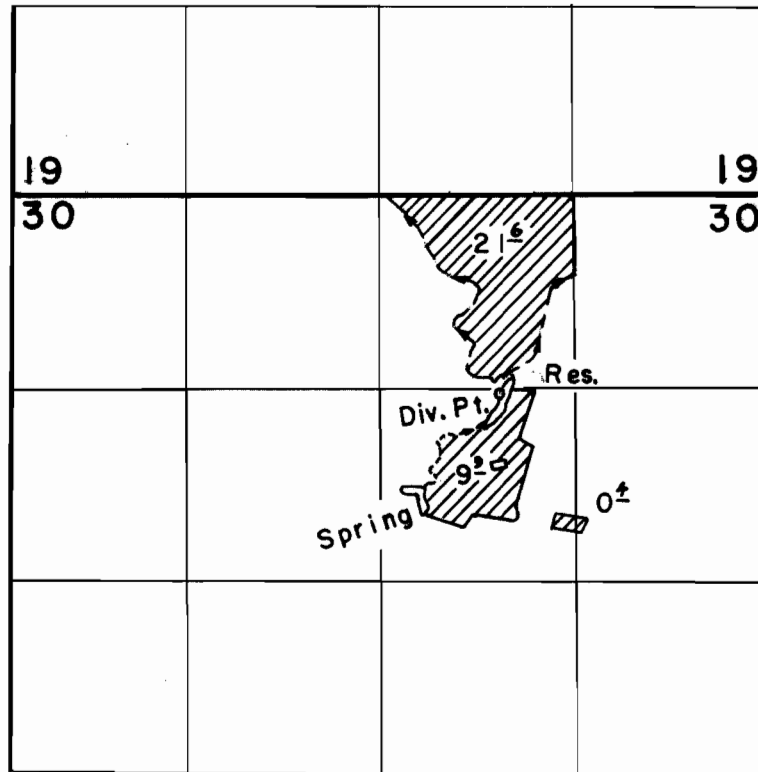

FINAL PROOF SURVEY UNDER

Application No. 332.23... Permit No. 26.265.
IN NAME OF

.....Gaylord M. Madison.....

Surveyed Aug. 21, 1964, by C. J. Gardner...