


T.3S.R.38E.W.M.

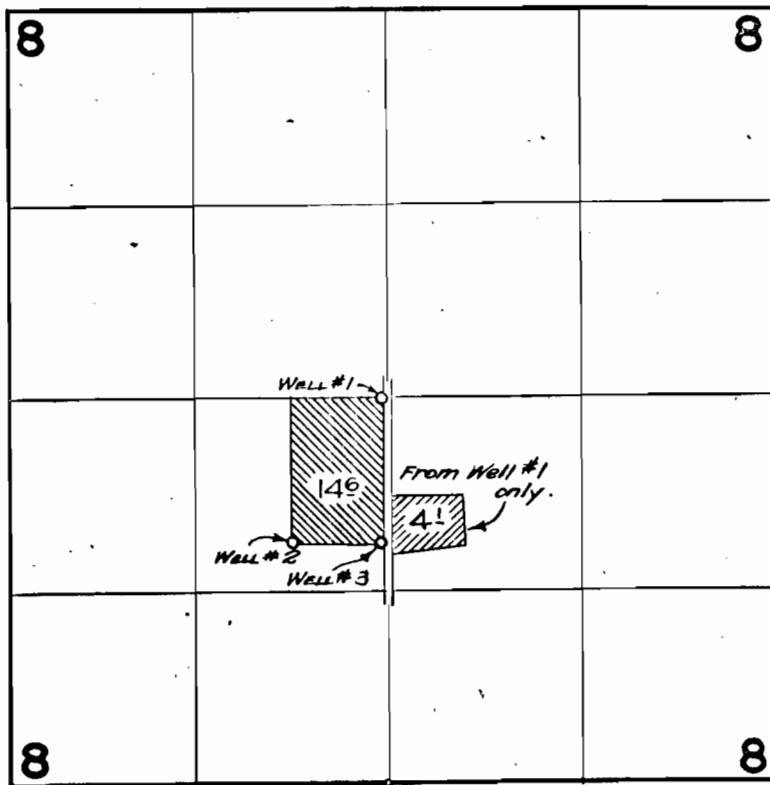

FINAL PROOF SURVEY
UNDER

G-1405 G-1280 (WELL #1)
G-1753 G-1603 (WELL #2)
Application No. G-2491 Permit No. G-2297 (WELL #3)
IN NAME OF

LA GRANDE CEMETERY MAINTENANCE DISTRICT

Surveyed Oct. 1, 1963, by T. Lauer