


Here's the cemetery Map - Please check on the possible 40 foot Road reservations, as well as measuring in the well locations. Thanks,
Bud

T.3S.R.38E.W.M.

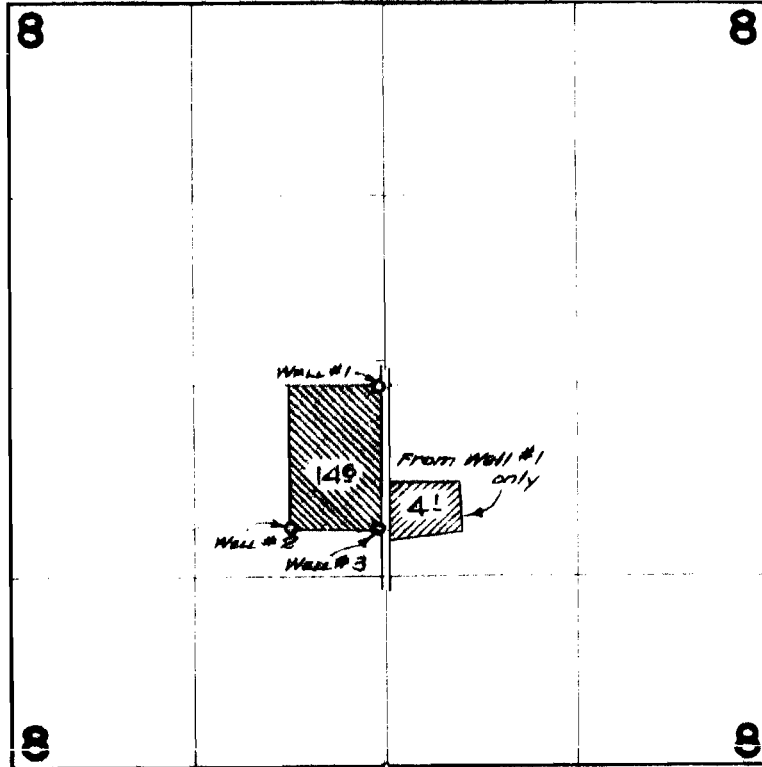

FINAL PROOF SURVEY
UNDER

Application No. ~~6-1495~~ ~~6-1763~~ ~~6-2491~~ Permit No. ~~6-1280 (WELL #1)~~ ~~6-1803 (WELL #2)~~ ~~6-2297 (WELL #3)~~
IN NAME OF

LA GRANDE CEMETERY MAINTENANCE DISTRICT

Surveyed Oct. 1 1963, by T. Lauer