


T. 1 N. R. 13 E. W. M.

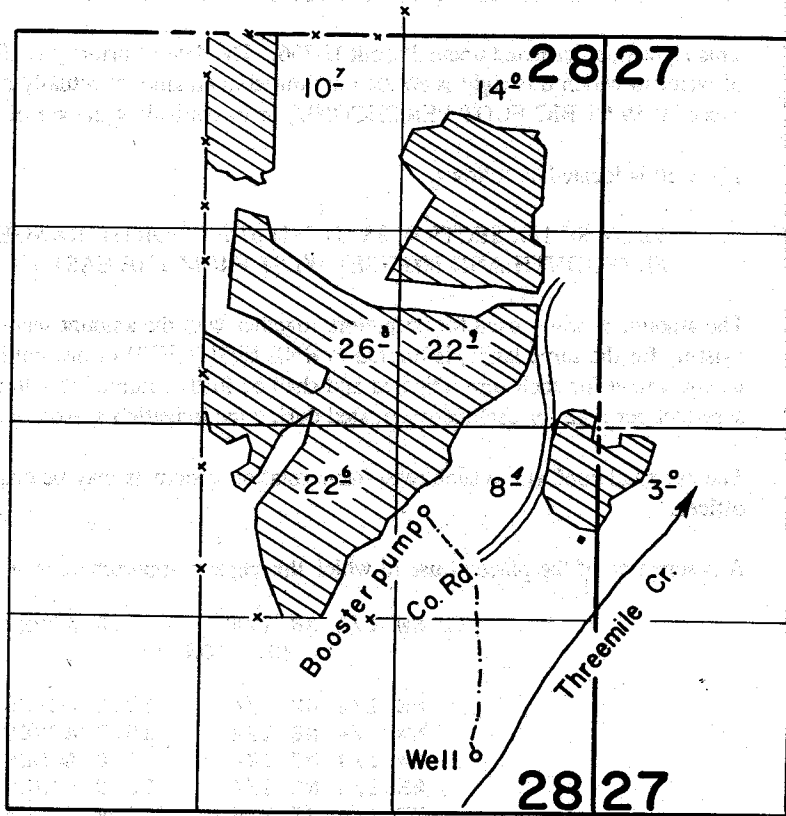

**FINAL PROOF SURVEY**  
UNDER

Application No. U-869... Permit No. U-756...  
IN NAME OF

**JOHN W. & ANGIE B. STARK**

Surveyed May 6... 19.65, by *L. W. Selbeck*