


T.4S.R.5W.W.M.

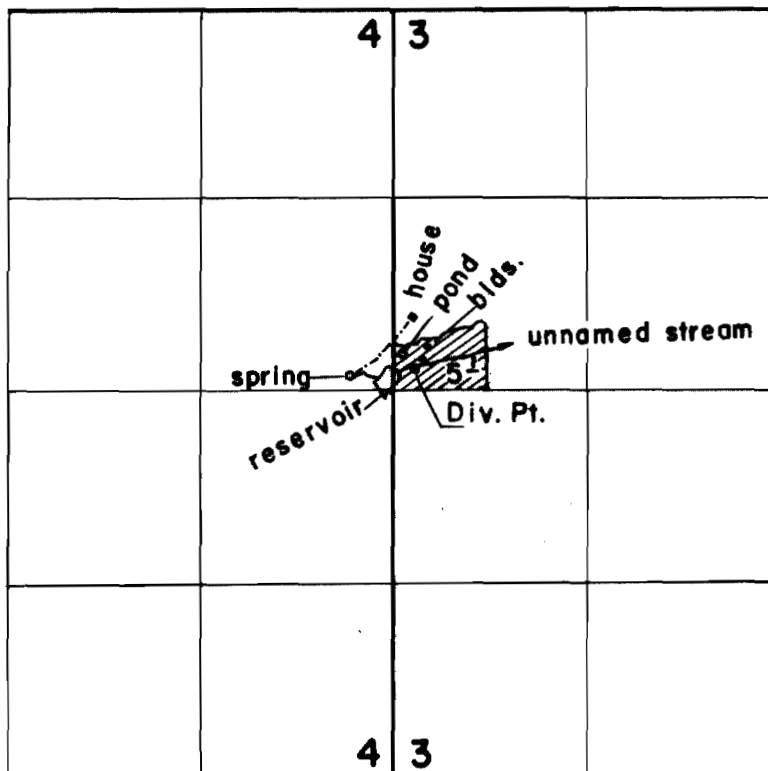

FINAL PROOF SURVEY
UNDER

R-38131

R-3158

Application No. 38132 Permit No. 28417
IN NAME OF

J.M. & B. Webster

Surveyed Aug. 27 1964 by R. Jackson