


T. 12 S. R. 4 W. W. M.

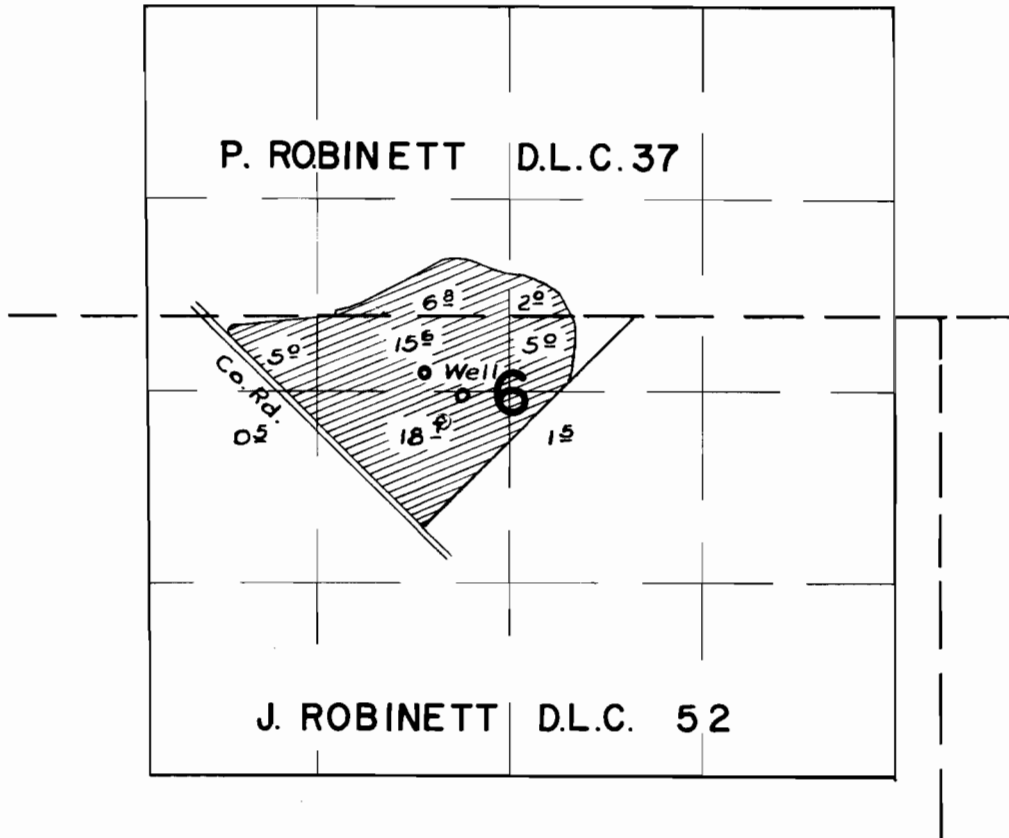

FINAL PROOF SURVEY
UNDER

Application No. G-560... Permit No. G-472...
IN NAME OF

..... MRS. ZACK TAYLOR

Surveyed 3 Aug. 1960, by *m. Bish*