


T.13S.R.4&5W.W.M.

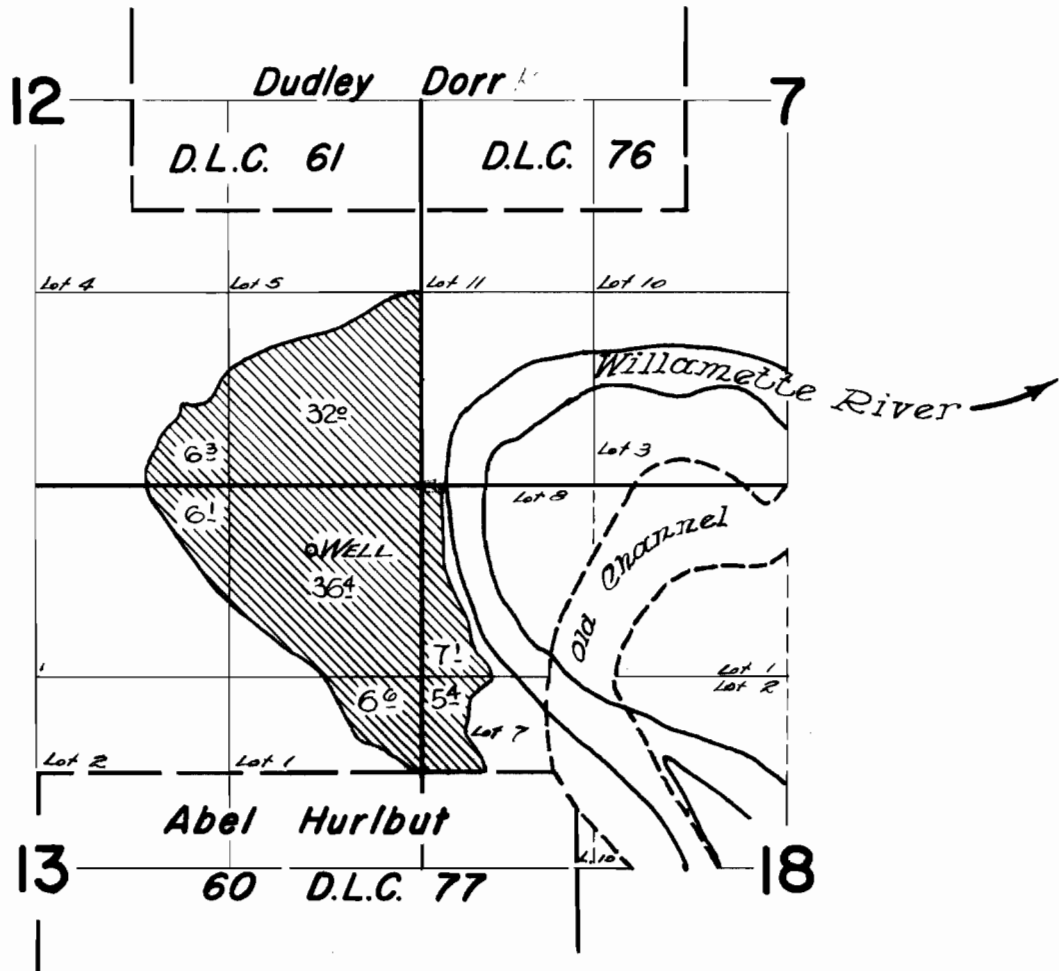

FINAL PROOF SURVEY
UNDER

Application No. G-909 Permit No. G-801
IN NAME OF

DALE & JEAN SCHROCK

Surveyed April 25 1963, by C. Baker