


T. 15 S. R. 5 W. W.M.

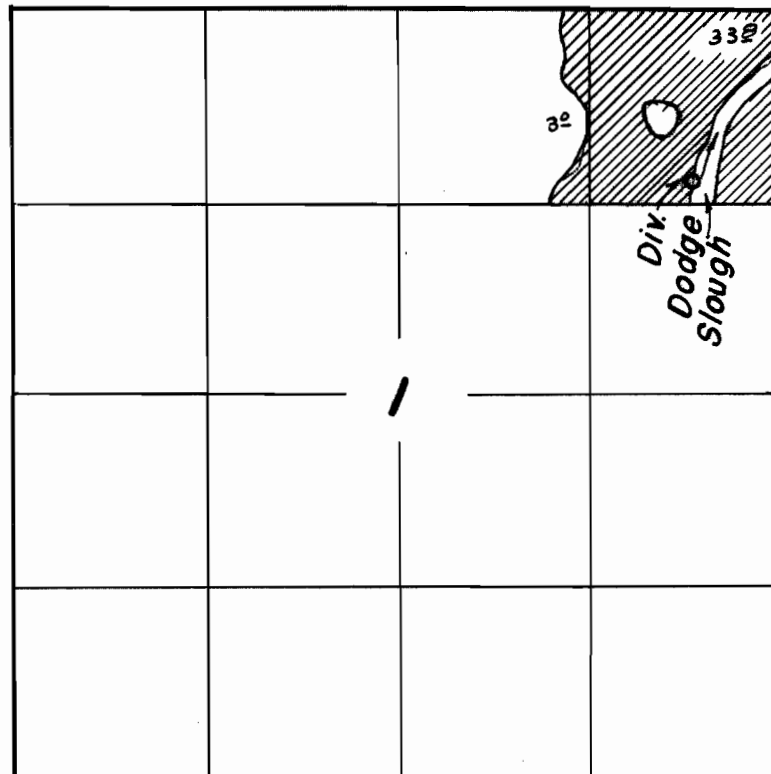

FINAL PROOF SURVEY
UNDER

Application No. 33033 Permit No. 26218
IN NAME OF

L.W. Rutherford

Surveyed Dec. 7 1964, by F. Slegmund