


T. 14 S. R. 5 W. W. M.

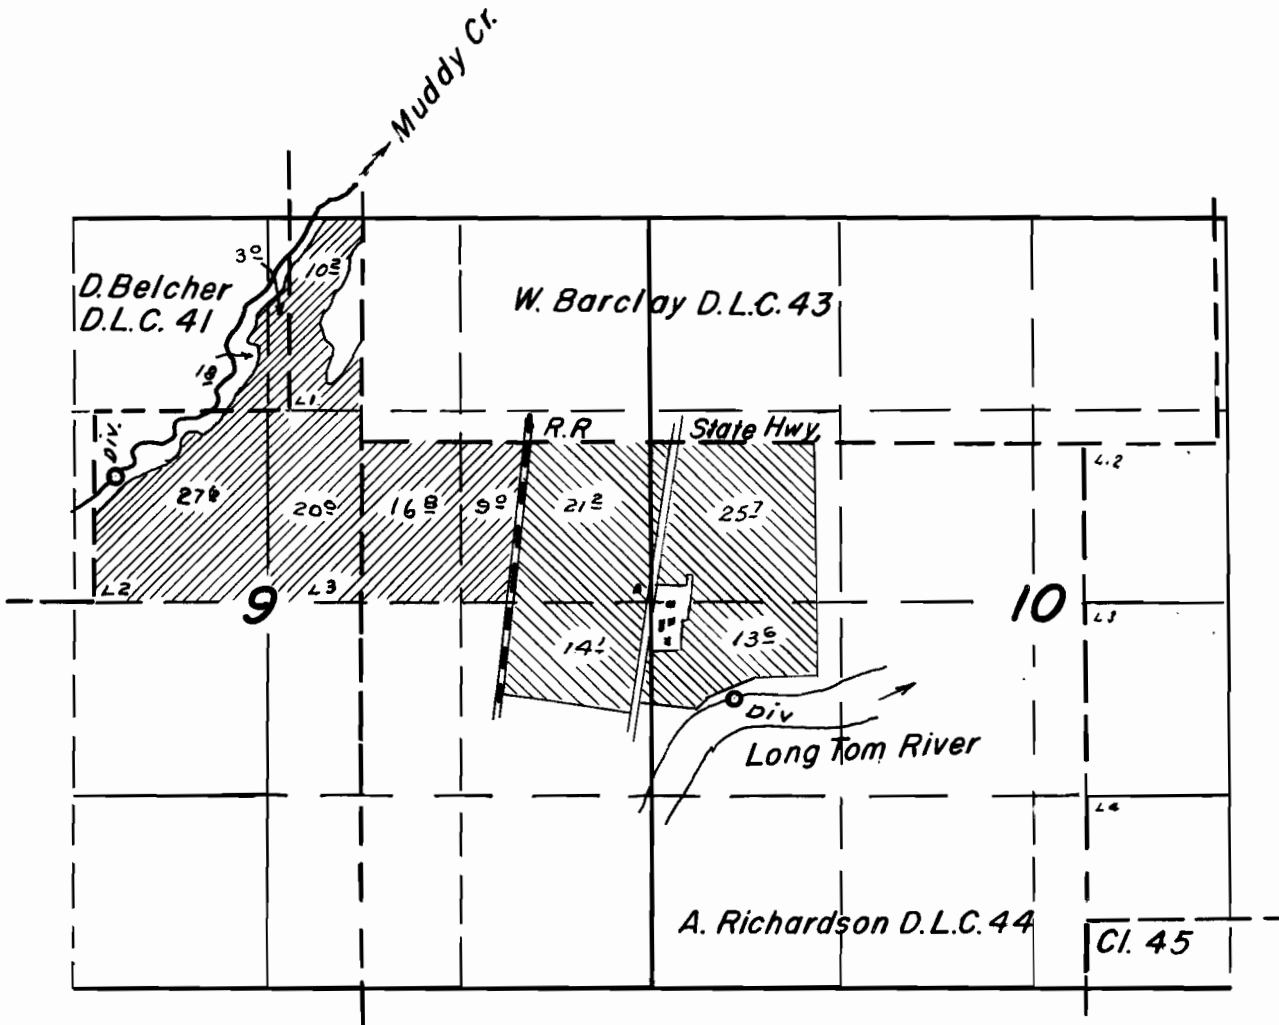

FINAL PROOF SURVEY 37329 
 UNDER 37330 

37329 27806
 Application No. 37330 Permit No. 27807
 IN NAME OF

Owen Kayser & Howard Barker

Surveyed Oct. 9 1964, by F. Siegmund