


T. 14 S. R. 5 W. W. M.

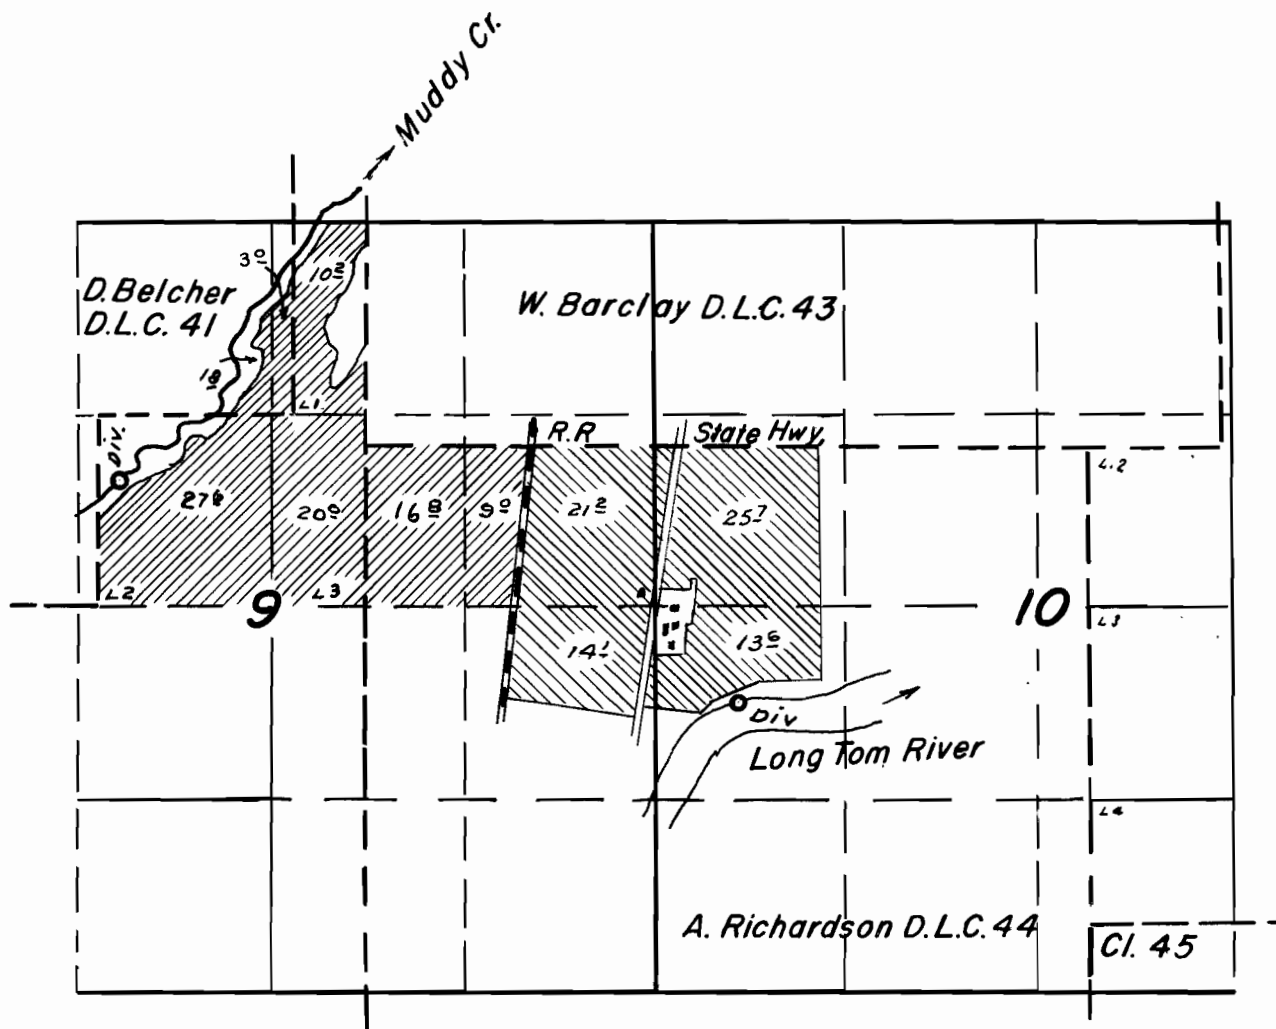

FINAL PROOF SURVEY 37329   
 UNDER 37330 

37329 27806  
 Application No. 37330 Permit No. 27807  
 IN NAME OF

**Owen Kayser & Howard Barker**

Surveyed Oct. 9 1964, by F. Siegmund