


T.10S.R.5W.W.M.

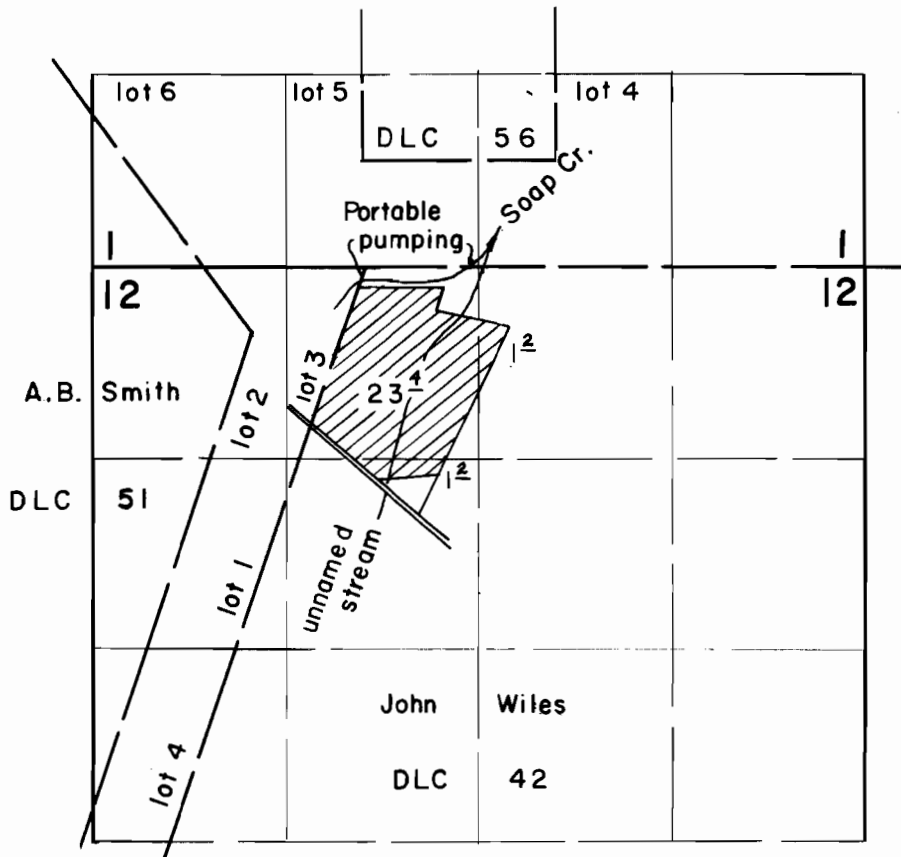

FINAL PROOF SURVEY UNDER

Application No. 38515..... Permit No. 28668.....
IN NAME OF

..... Allen E. Fintel

Surveyed Oct. 6..... 1964, by F. Siegmund.....