


T.14S.R.5W.W.M.

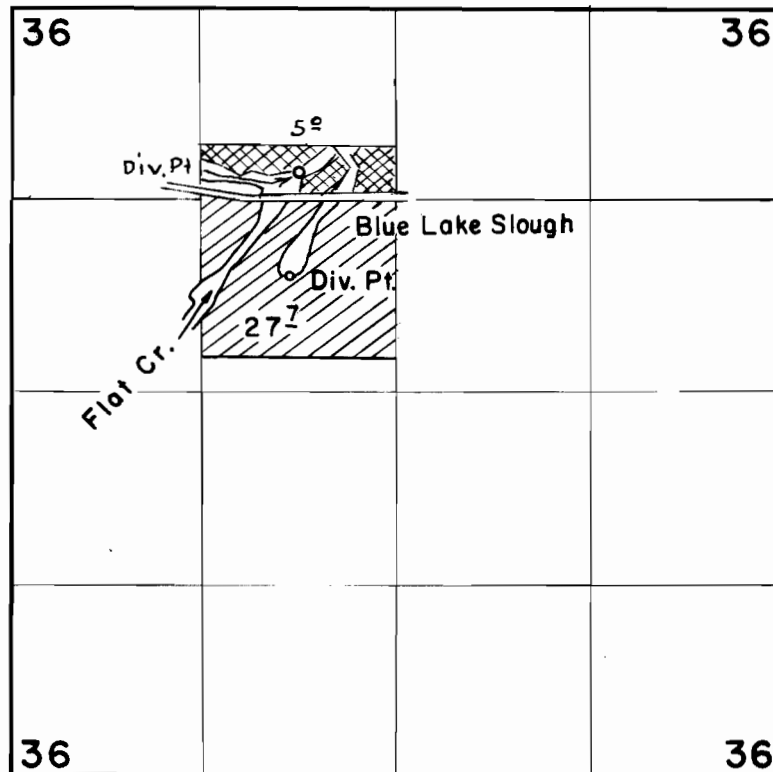

38844



38843

FINAL PROOF SURVEY
UNDER

Application No. 38844... Permit No. 28896...
IN NAME OF

Ralph & Nica McGee

Surveyed Aug. 6, 1964, by F. Siegmund