


T.14S.R.5W.W.M.

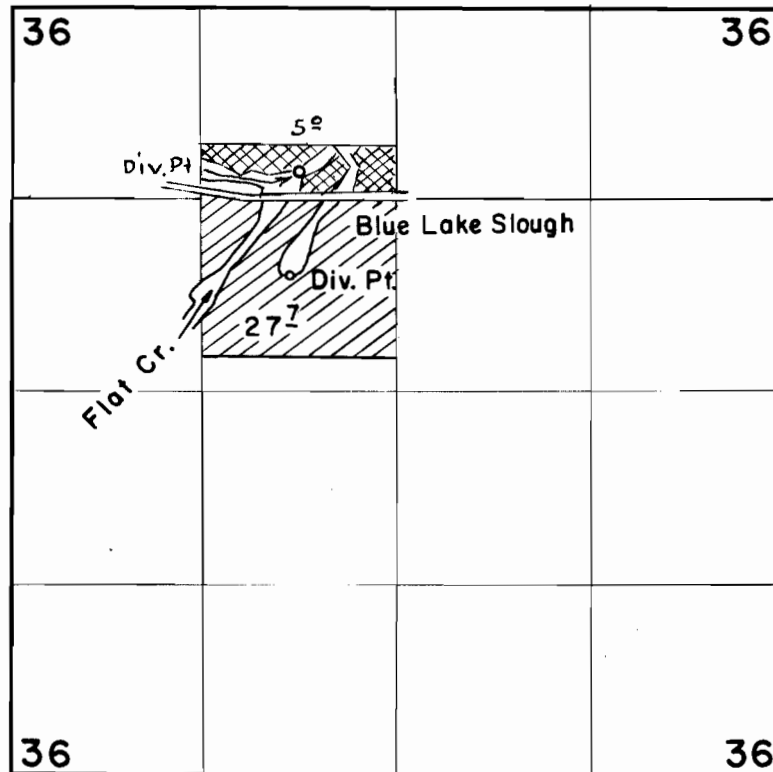

38844



38843

FINAL PROOF SURVEY
UNDER

38844 28896
Application No. 38843 Permit No. 28895
IN NAME OF

..... **Ralph & Nica McGee**

Surveyed Aug. 6, 1964, by F. Siegmund