


T. 14 S. R. 5 W. W. M.

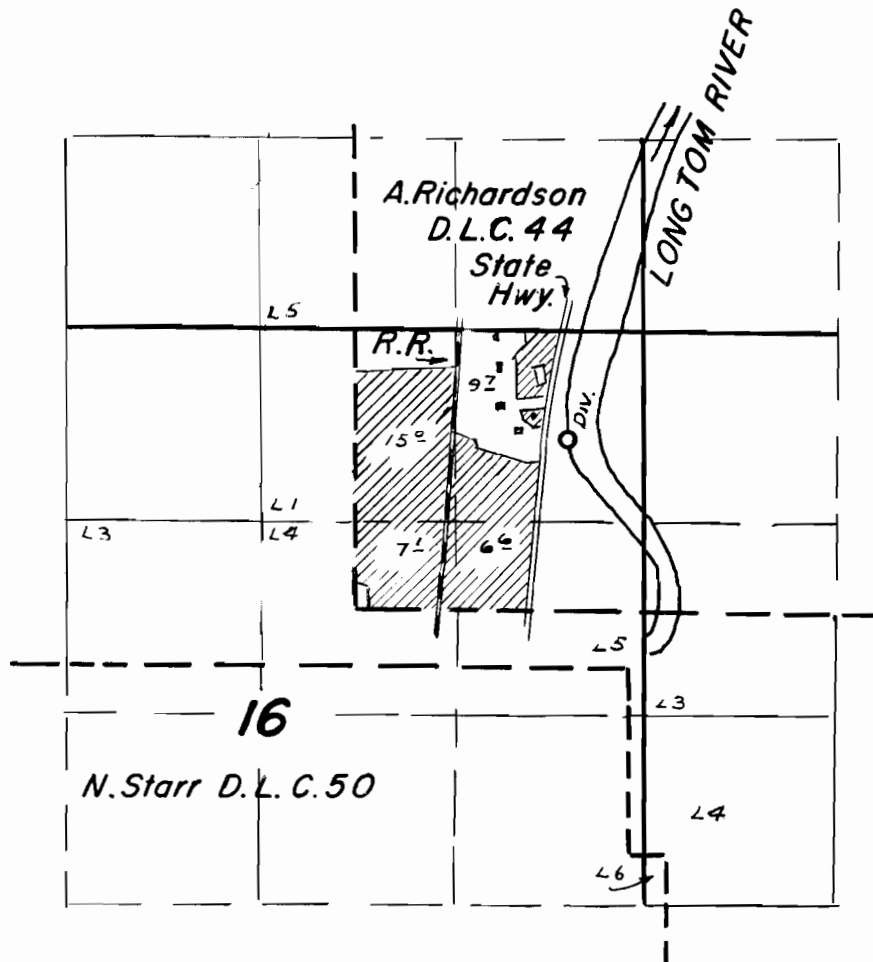

**FINAL PROOF SURVEY**  
UNDER

Application No. 39290 Permit No. 29259  
IN NAME OF

**Ernest Von Krosigk**

Surveyed Oct. 9 1964, by F. Siegmund