


T.4S. R.1&2E. W.M.

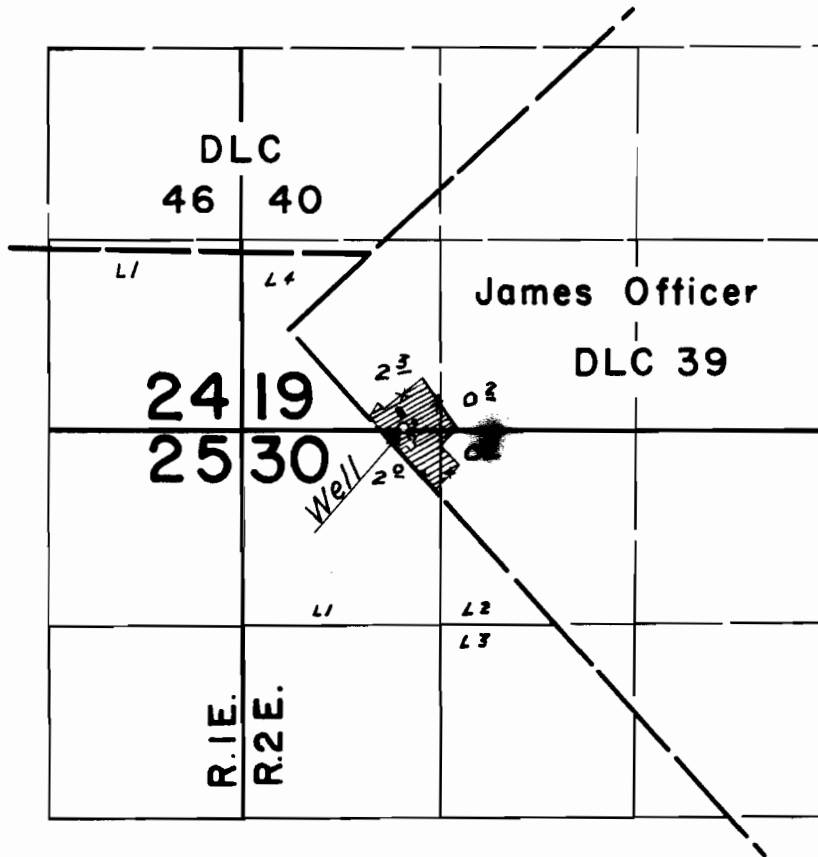

**FINAL PROOF SURVEY**  
UNDER

Application No. G-1118 Permit No. G-1043  
IN NAME OF

**PETER WETTEN**

Surveyed Sept. 1, 1964, by *C.J. Gardner*