


T.2S. R.3E. W.M.

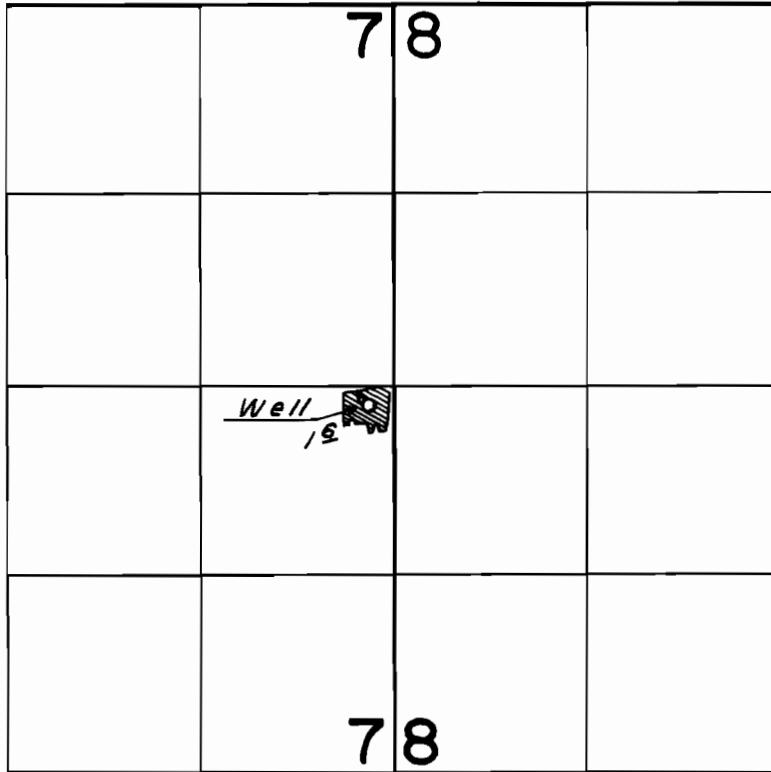

**FINAL PROOF SURVEY**  
UNDER

Application No. G-1740 Permit No. G-1592  
IN NAME OF

**S. PARZY ROSE II &/or PHYLLIS R. ROSE**

Surveyed August 12, 1964, by *C. J. Gardner*