


# T. 4 S. R. 1 E. W. M.

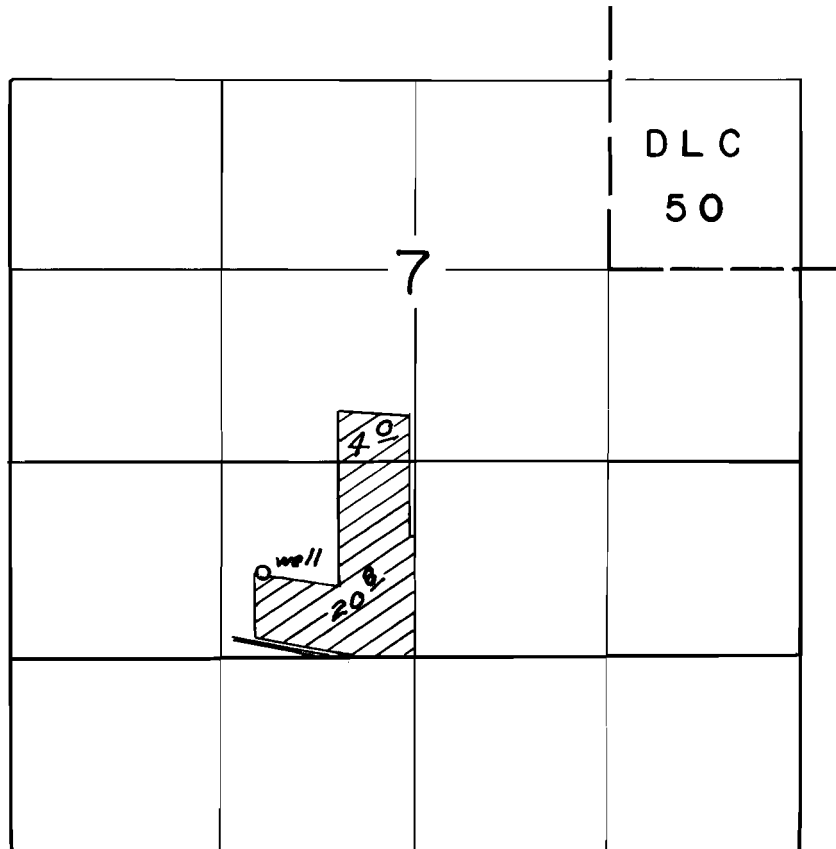

## FINAL PROOF SURVEY UNDER

Application No. G-2043 Permit No. G-1878  
IN NAME OF

N.E. POWELL

Surveyed July 3, 1964 by C. J. Gardner