


T. 3 S. R. 4 E. W.M.

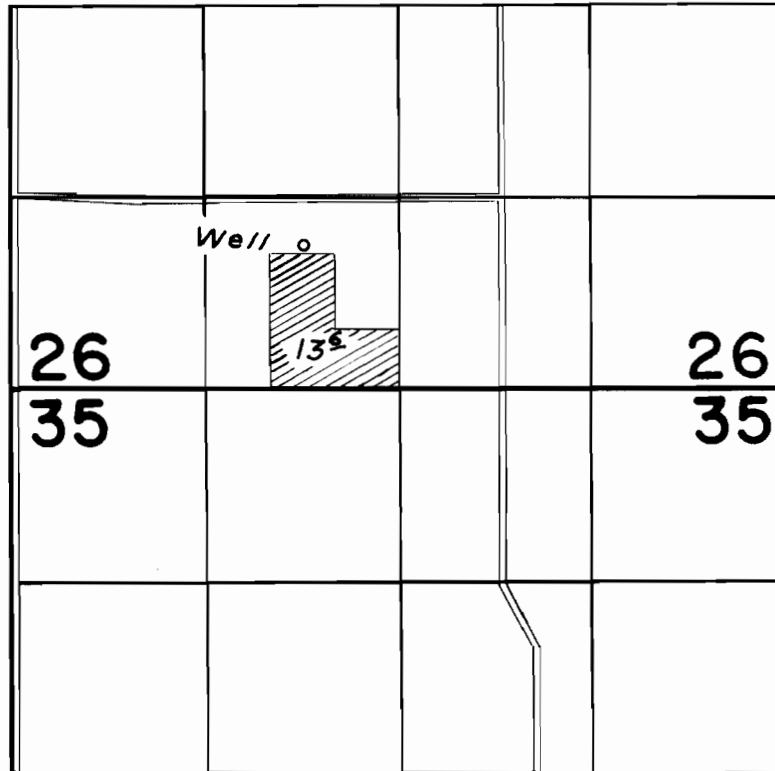

FINAL PROOF SURVEY
UNDER

Application No. G-2564. Permit No. G-2413.
IN NAME OF

W. O. YOUNGBERG

Surveyed August 14, 1964, by C. J. Gardner.