


T. 3 S. R. 2 E. W. M.

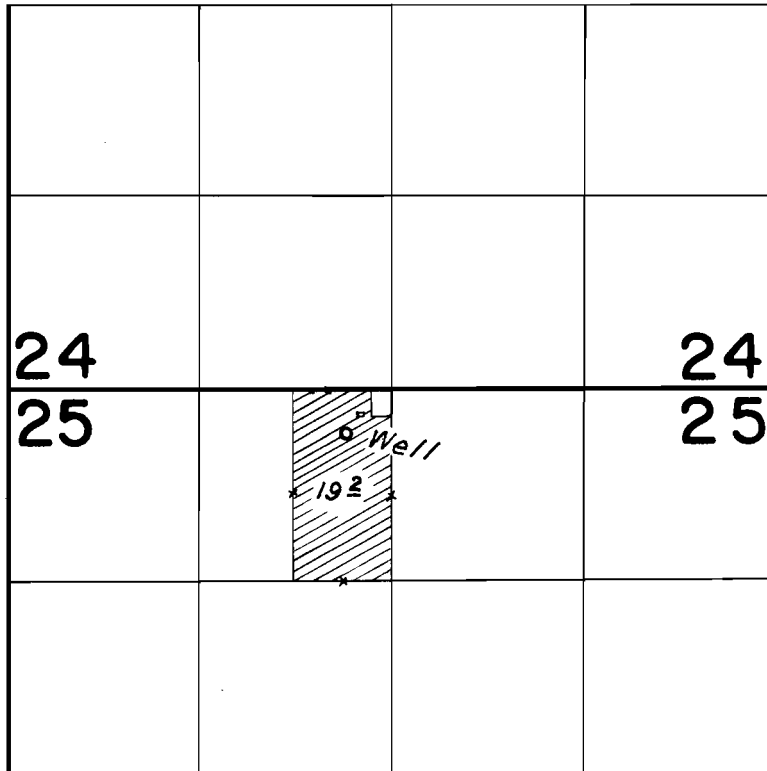

FINAL PROOF SURVEY
UNDER

Application No. G-2640 Permit No. G-2457
IN NAME OF

WM. N. SMITH

Surveyed August 12, 1964, by C. J. Gardner