


T.2S. R.2E. W.M.

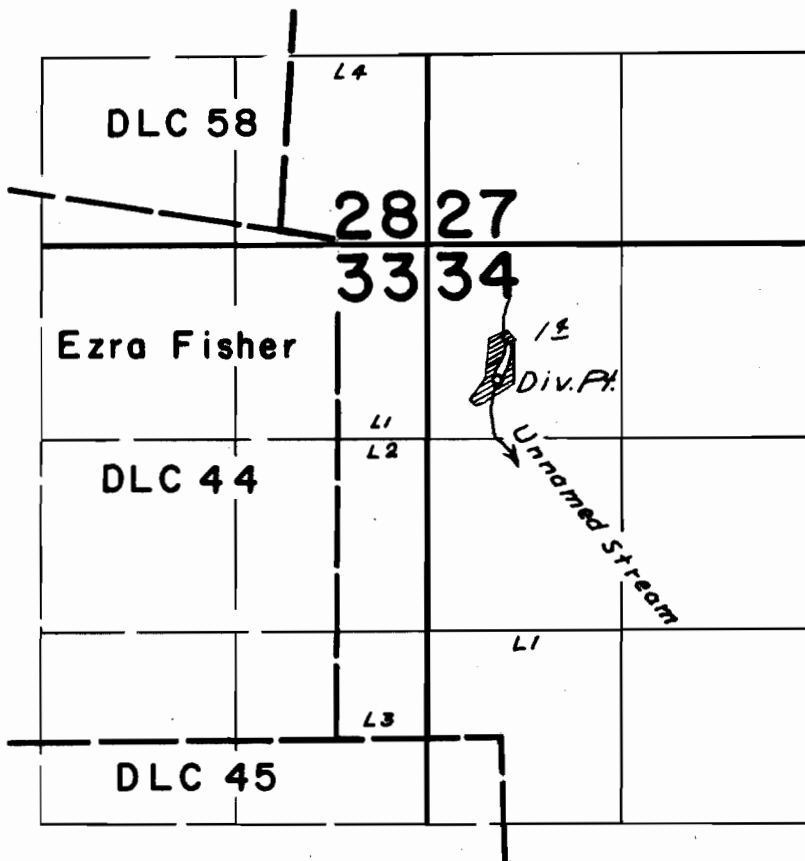

FINAL PROOF SURVEY
UNDER

R-33154 R-2261
Application No. 33116 Permit No. 26272
IN NAME OF

.....WILLIAM WHITE.....

Surveyed August 11, 1964, by C.J. Gardner