


T.5S. R.2E. W.M.

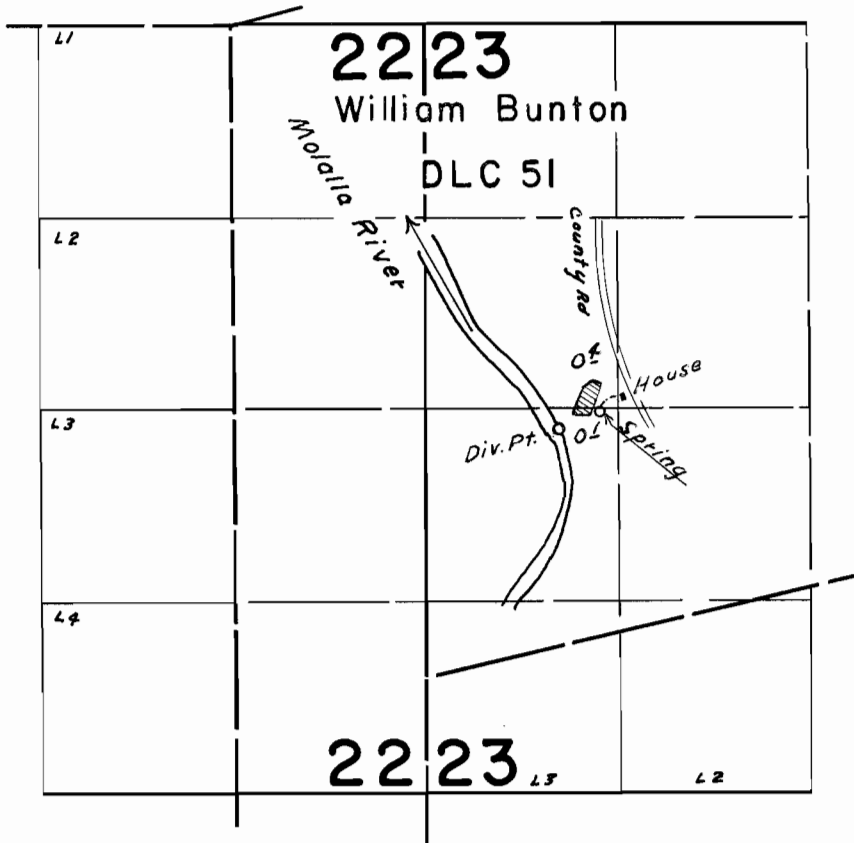

**FINAL PROOF SURVEY**  
UNDER

Application No. 33617 Permit No. 26582  
IN NAME OF

**ALBERT DUTTON**

Surveyed Sept. 3, 1964, by *C.J. Gardner*