


# T. 3 S. R. 1 W. W. M.

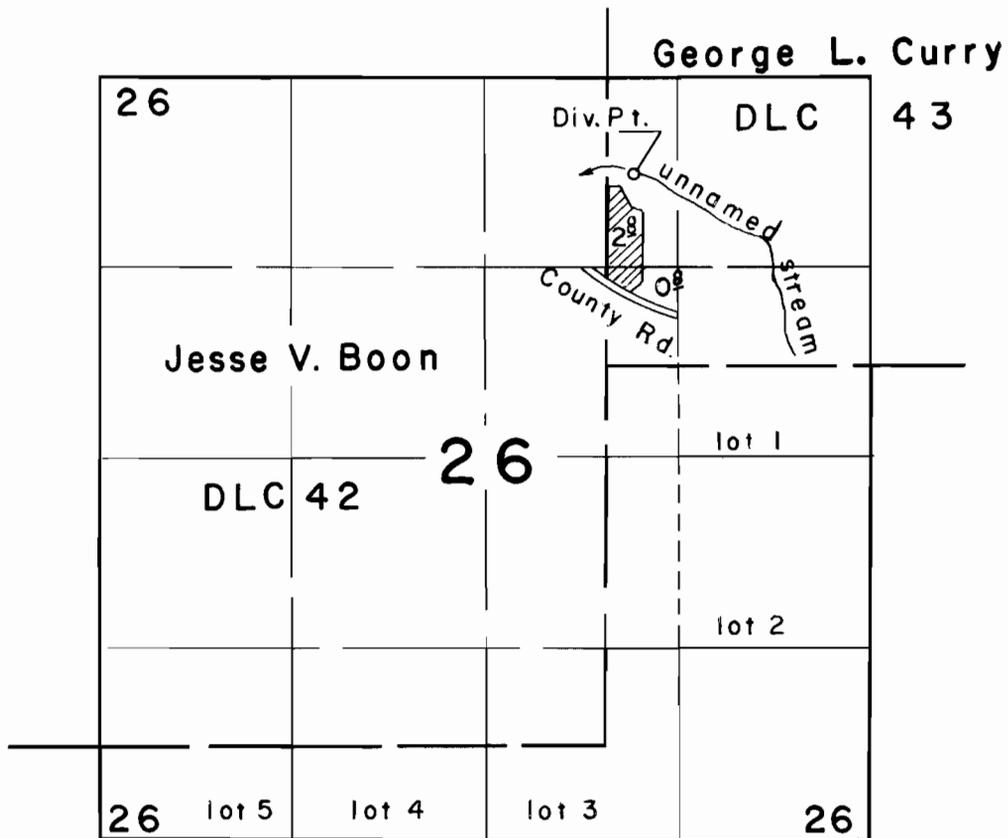

## FINAL PROOF SURVEY UNDER

Application No. 34177 Permit No. 26919  
IN NAME OF

**Richard Paul Hemmerling**

Surveyed Aug 28 1964 by C.J. Gardner