


T.4S. R.1E. W.M.

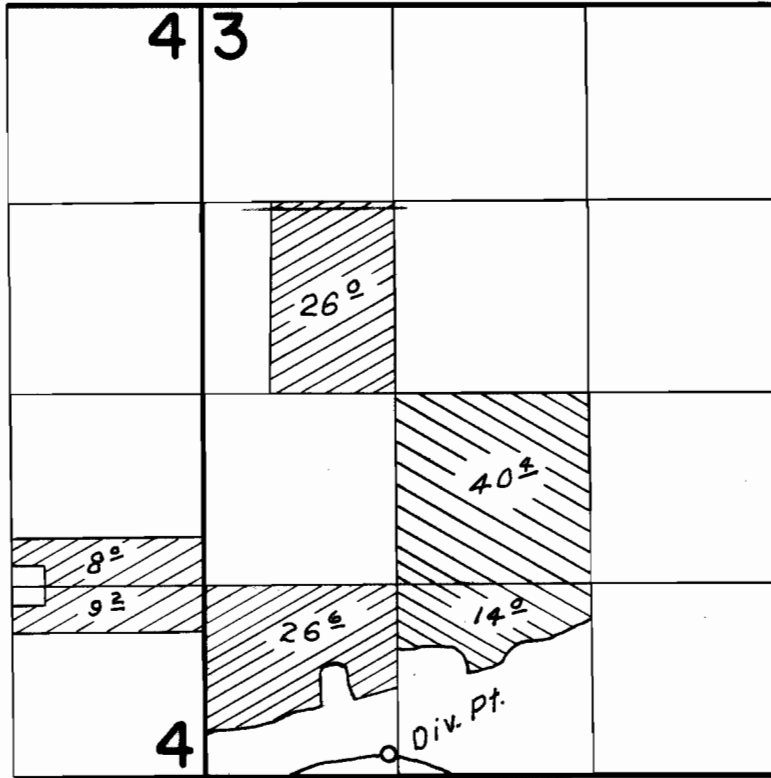

 *Tofte*
 *Beals*

FINAL PROOF SURVEY
UNDER

Application No. 37375 Permit No. 27820
IN NAME OF

HARVEY TOFTE—MAPLE COLE BEALS

Surveyed July 23, 1964, by C. J. Gardner