


T.4S. R.3E. W.M.

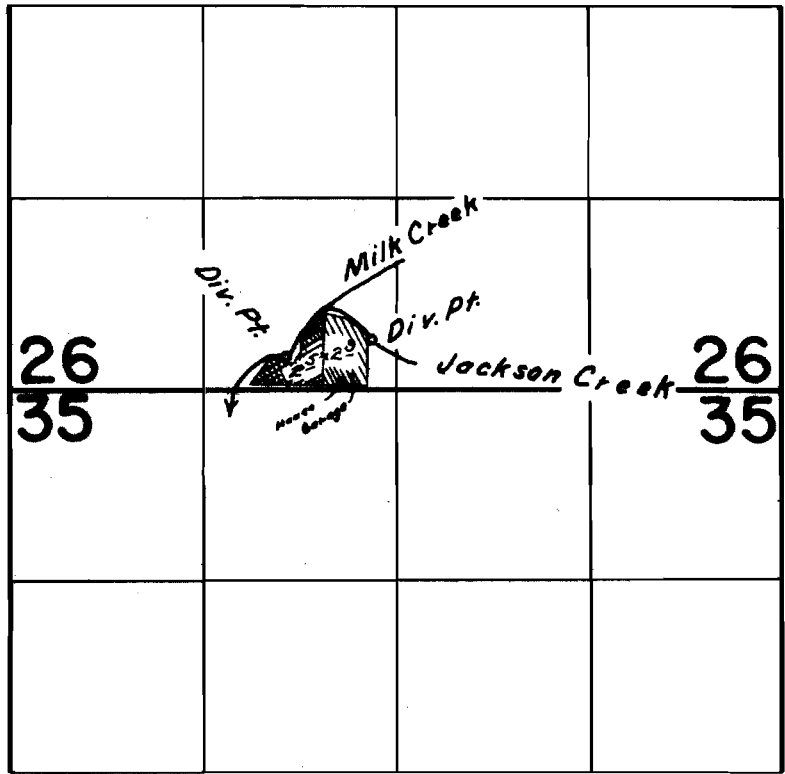

 Jackson Creek
 Milk Creek

FINAL PROOF SURVEY
UNDER

Application No. 37554 Permit No. 28034
IN NAME OF

GEORGE KRICK

Surveyed July 22, 1964, by C. J. Gardner