


T.5 S. R.2 E. W.M.

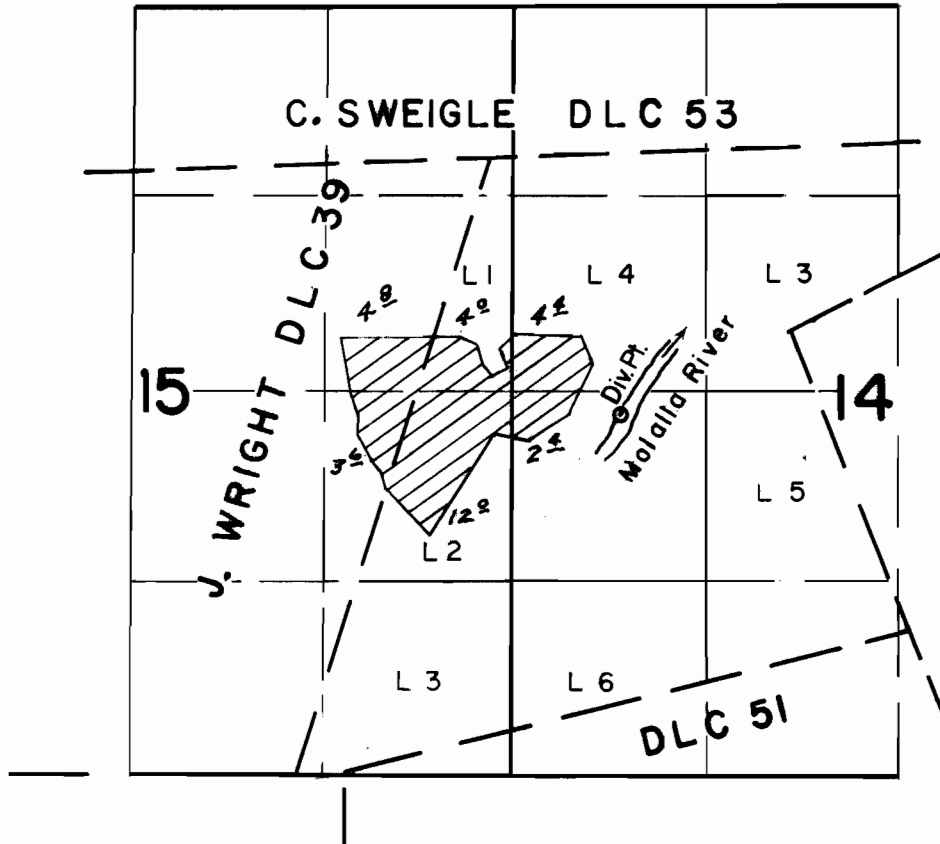

**FINAL PROOF SURVEY  
UNDER**

Application No. 37792 Permit No. 28152  
IN NAME OF

**IRVIN SHARP**

Surveyed July 2, 1964, by C. Gardner

1964-M