


T.5S. R.3E. W.M.

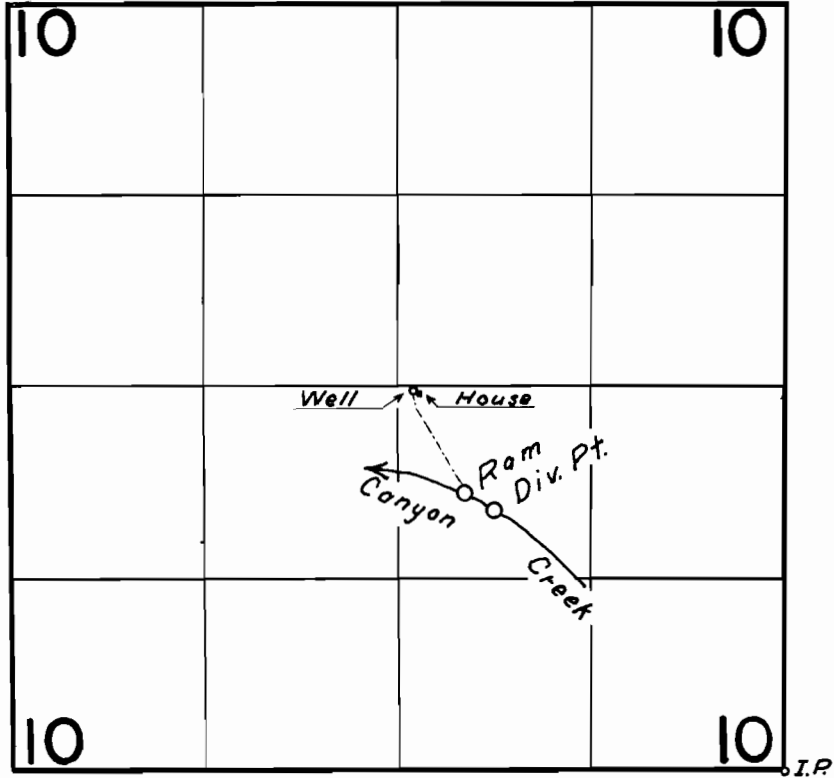

FINAL PROOF SURVEY
UNDER

Application No. 38054 Permit No. 28350
IN NAME OF

ALONZO FOLTZ

Surveyed August 31, 1964, by C. J. Gardner.