T.3S.R.3E.W.M.

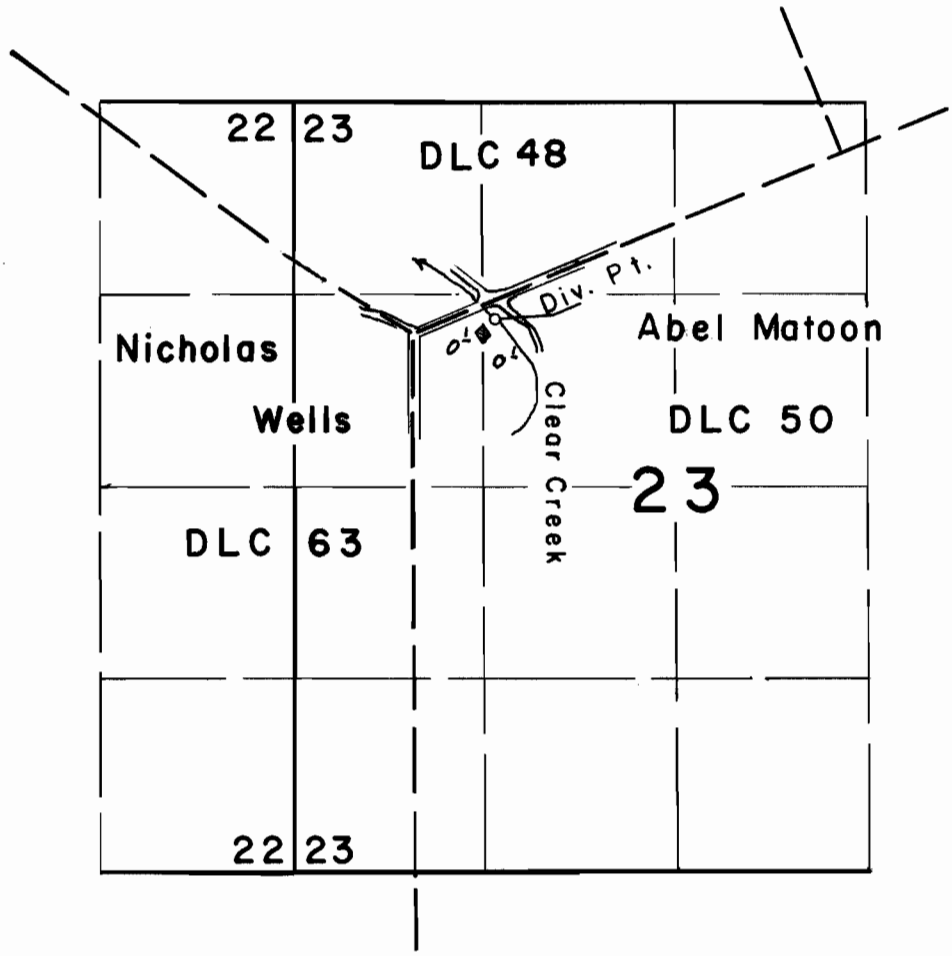

FINAL PROOF SURVEY
UNDER

Application No. 38638 Permit No. 28761
IN NAME OF

L. C. Hubbard

Surveyed Sept 3 1964, by C.J. Gardner

1964-0