


T.2S. R.3E. W.M.

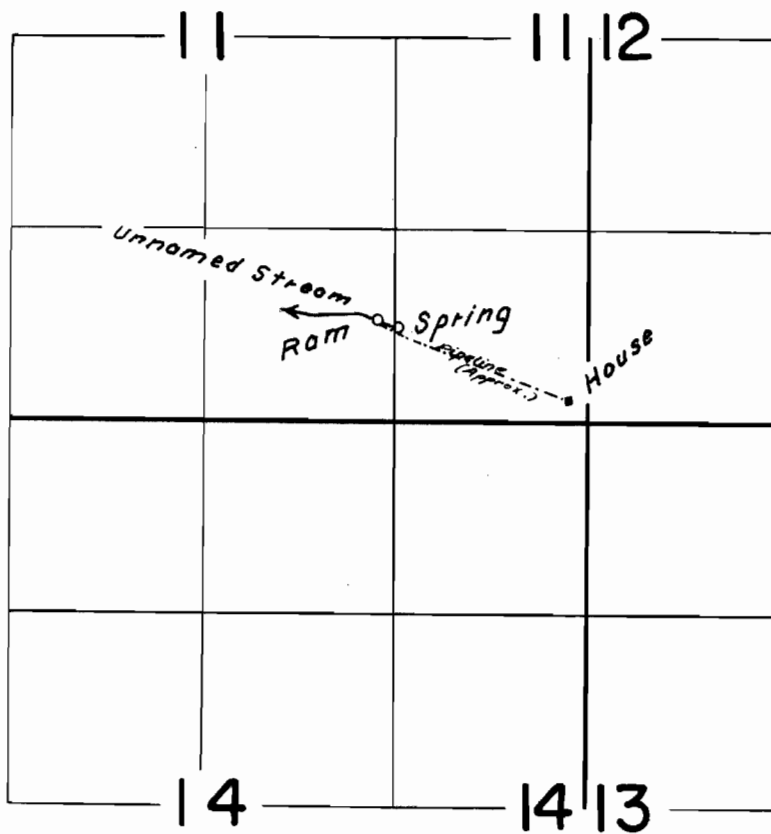

**FINAL PROOF SURVEY**  
UNDER

Application No. 38898. Permit No. 28957.  
IN NAME OF

**JOHN TRUMAN & SOPHIE L. RICHEY**

Surveyed August 13, 1964, by *C.J. Gardner*