


T.2S. R.2E. W.M.

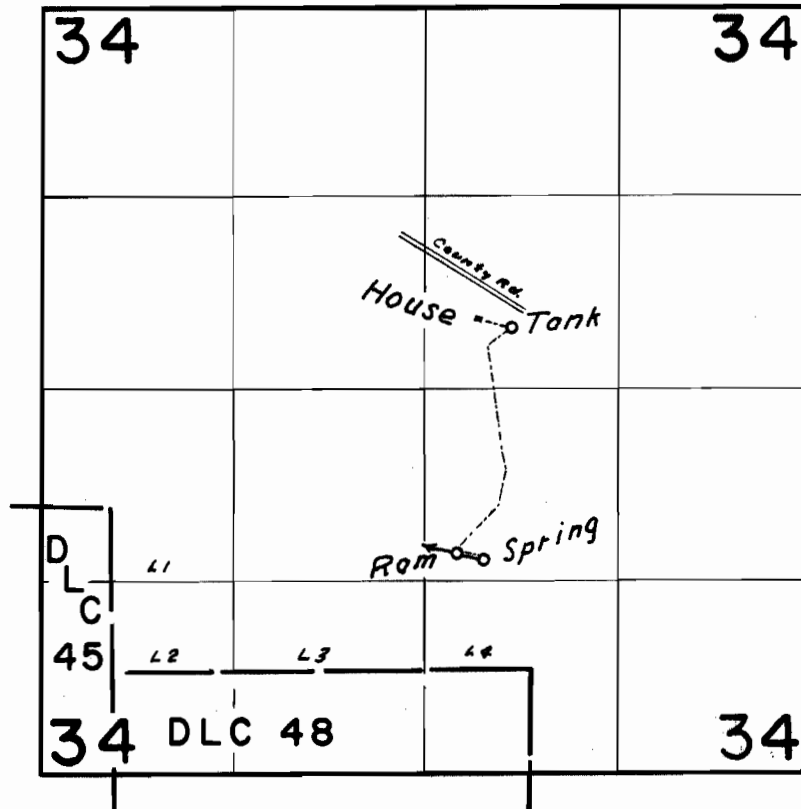

FINAL PROOF SURVEY
UNDER

Application No. 39124 Permit No. 29121
IN NAME OF

ROY SIDOR, JR.

Surveyed August 11, 1964, by C.J. Gardner.