


T.2S. R.2E. W.M.

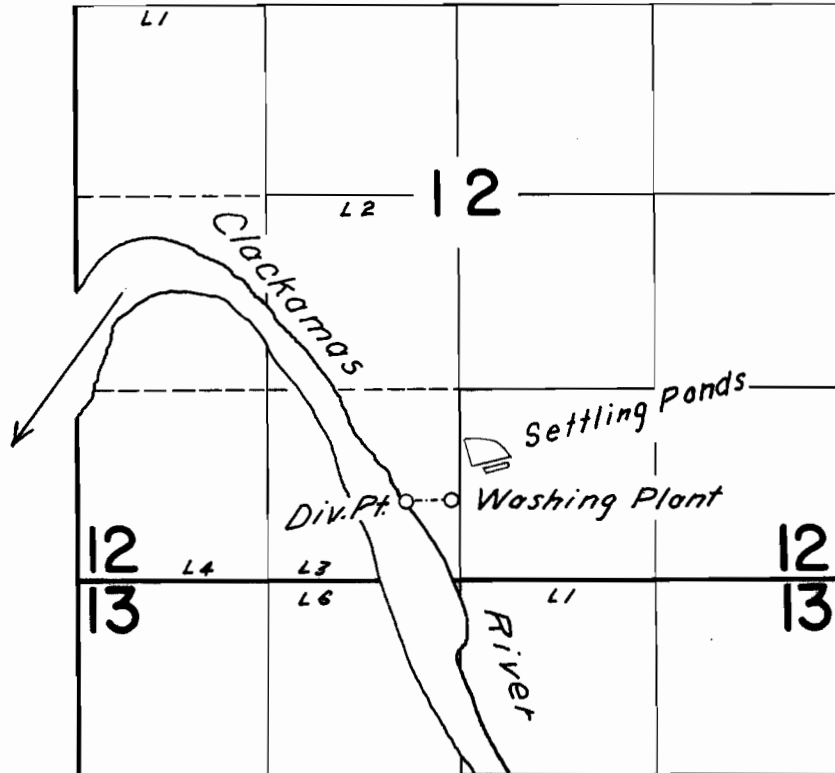

FINAL PROOF SURVEY
UNDER

Application No. 39399 Permit No. 29291
IN NAME OF

SLATE - HALL

Surveyed August 12, 1964, by *C.J. Gardner*