


T.24S.R.13W.W.M.

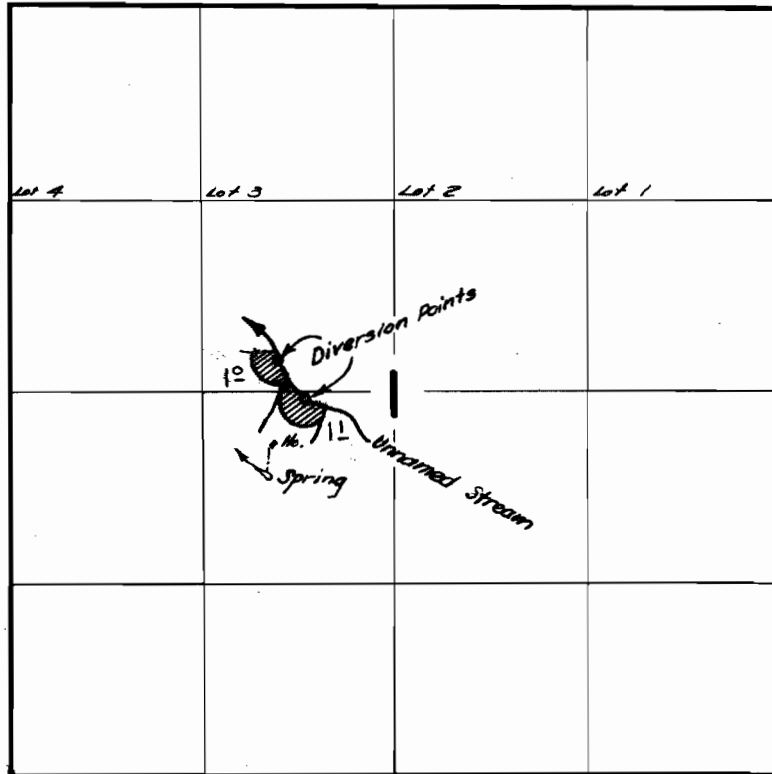

FINAL PROOF SURVEY
UNDER

Application No. 32221.... Permit No. 25423...
IN NAME OF

WALTER J. & RUTH E. EDLEFSEN

Surveyed August 8, 1903, by R. H. Jackson