


T.26S. R.3&4W. W.M.

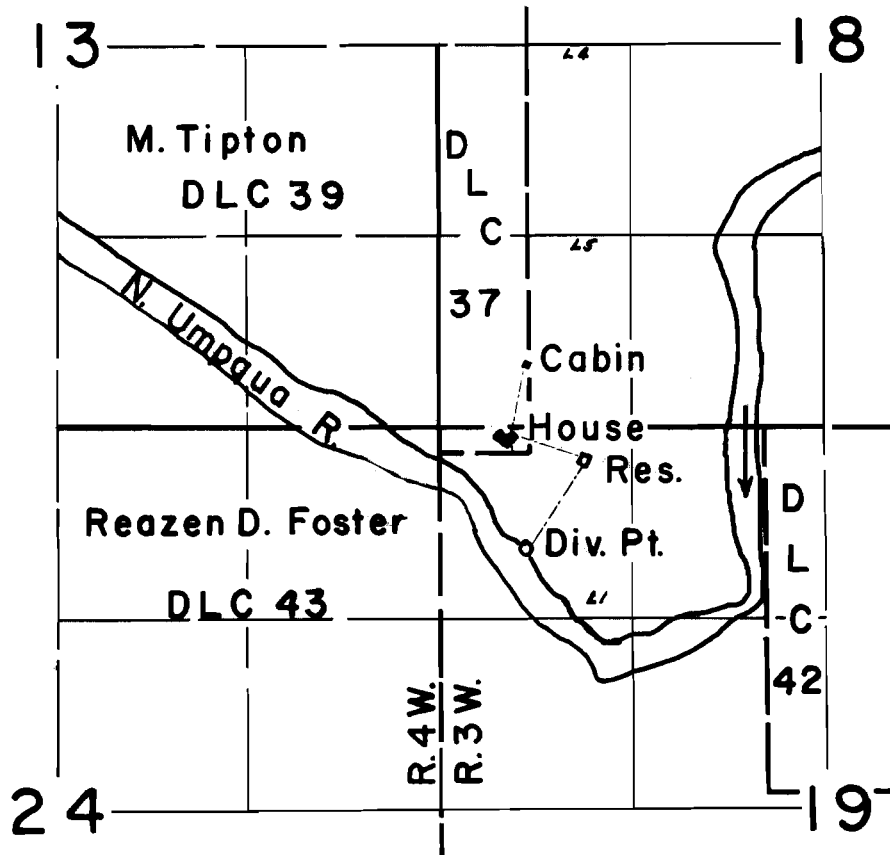

**FINAL PROOF SURVEY**  
UNDER

Application No. 32525 Permit No. 25772  
IN NAME OF

WALTON L. H. OSBORNE

Surveyed July 17, 1964, by C. J. Gordon