


T.28 & 29S. R.5W. W.M.

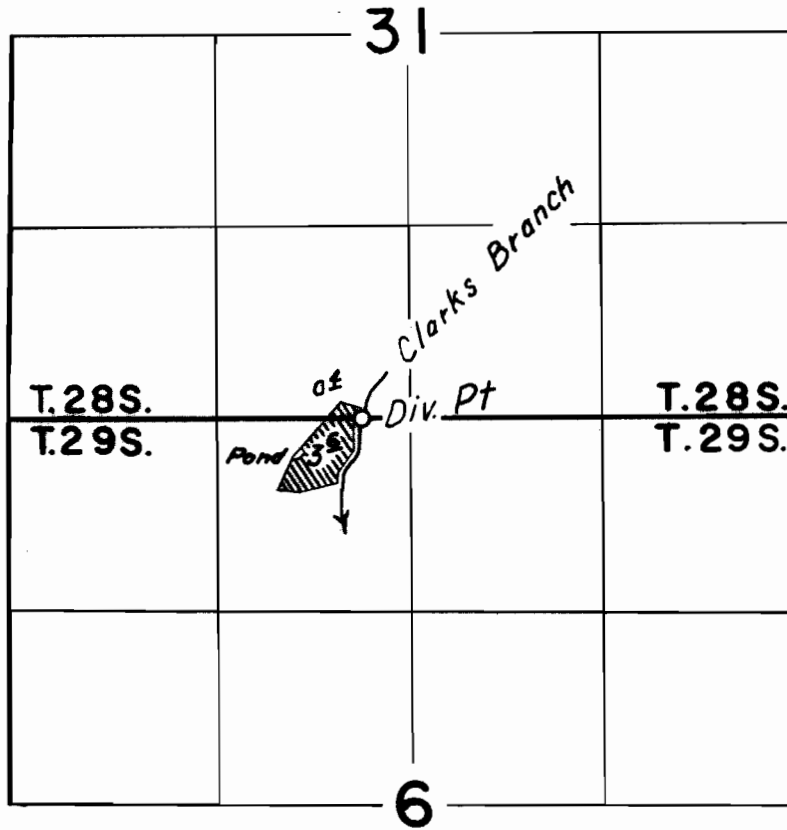

FINAL PROOF SURVEY
UNDER

Application No. 33774 Permit No. 26665
IN NAME OF

ARTHUR KLASSEN

Surveyed Aug. 4, 1964, by C.J. Gardner