


# T.26S. R.6W. W.M.

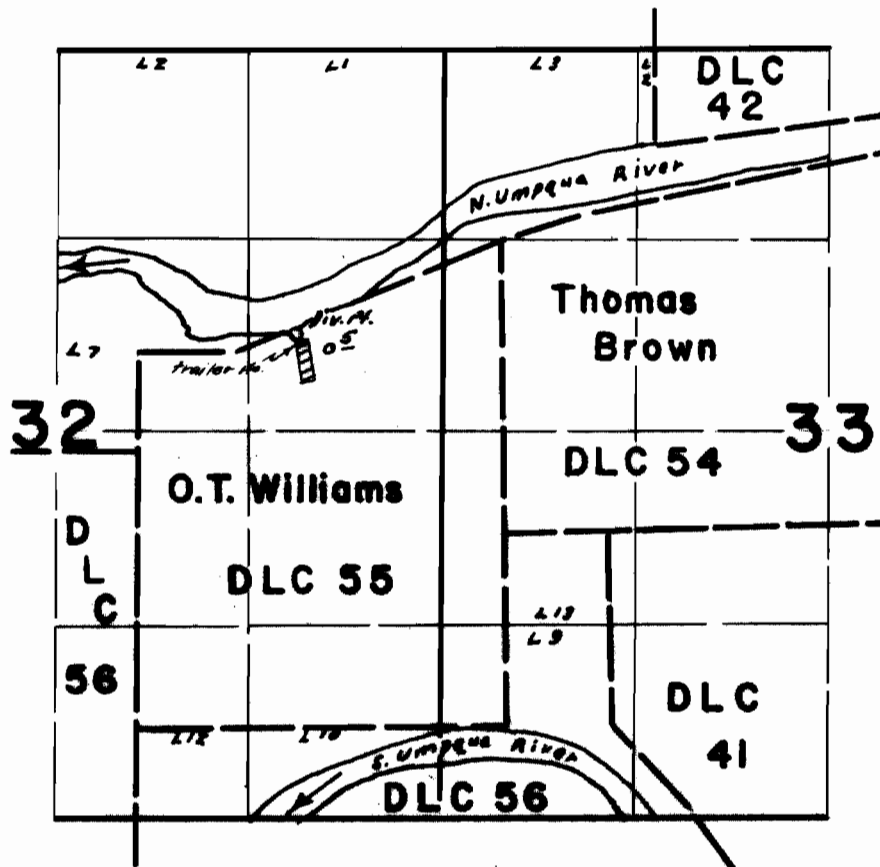

## FINAL PROOF SURVEY UNDER

Application No. 34335... Permit No. 27005...  
IN NAME OF

E. G. TROZELLE

Surveyed July 14, 1964, by *C.J. Gardner*