


T.25S. R.7W. W.M.

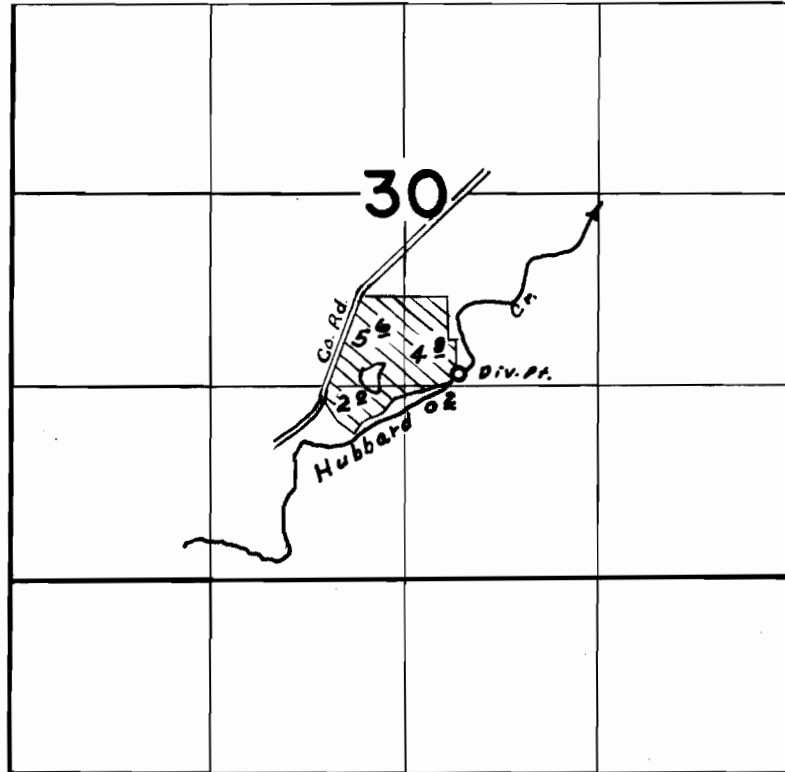

FINAL PROOF SURVEY
UNDER

Application No. 34615 Permit No. 27180
IN NAME OF

BEN J. AMERSON

Surveyed July 8, 1964, by C. J. Gardner